


T. 14 S., R. 9 W., W.M.

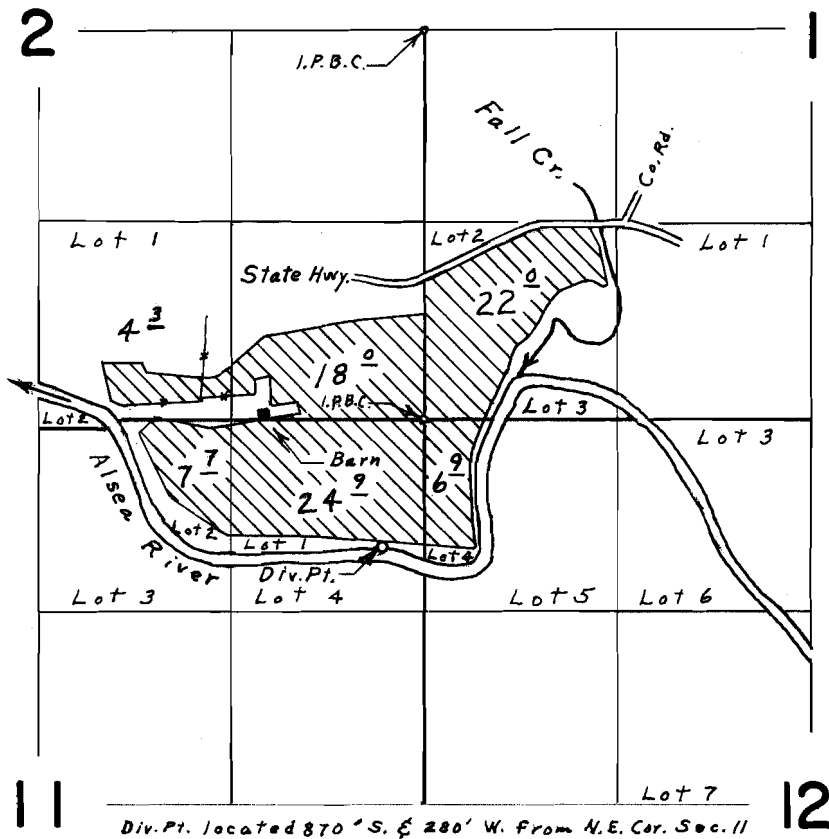

FINAL PROOF SURVEY
UNDER

Application No. 43962 Permit No. 32843
IN NAME OF

MARVIN C. ELLIS

Surveyed Feb. 2, 1973, by L. E. Gould