


T. 8 S., R10W., W.M.

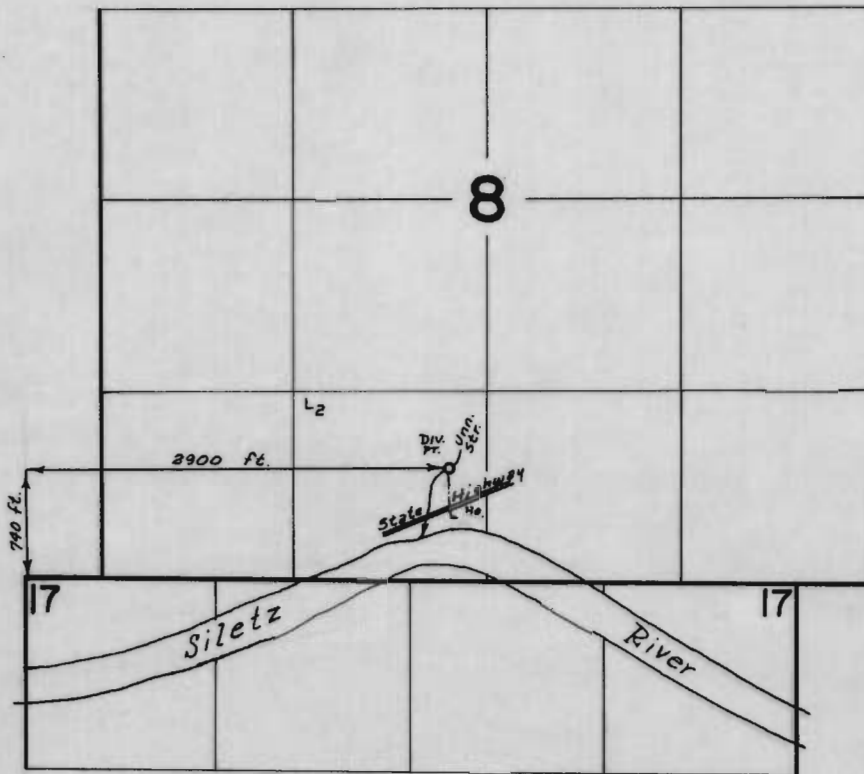

FINAL PROOF SURVEY UNDER

Application No. 47646 Permit No. 35249
IN NAME OF

LESLIE A. and MARY K. MUSSMAN

Surveyed Aug 24 19 72 by D. Norby