


T. 6 S. R. 2 W. W. M.

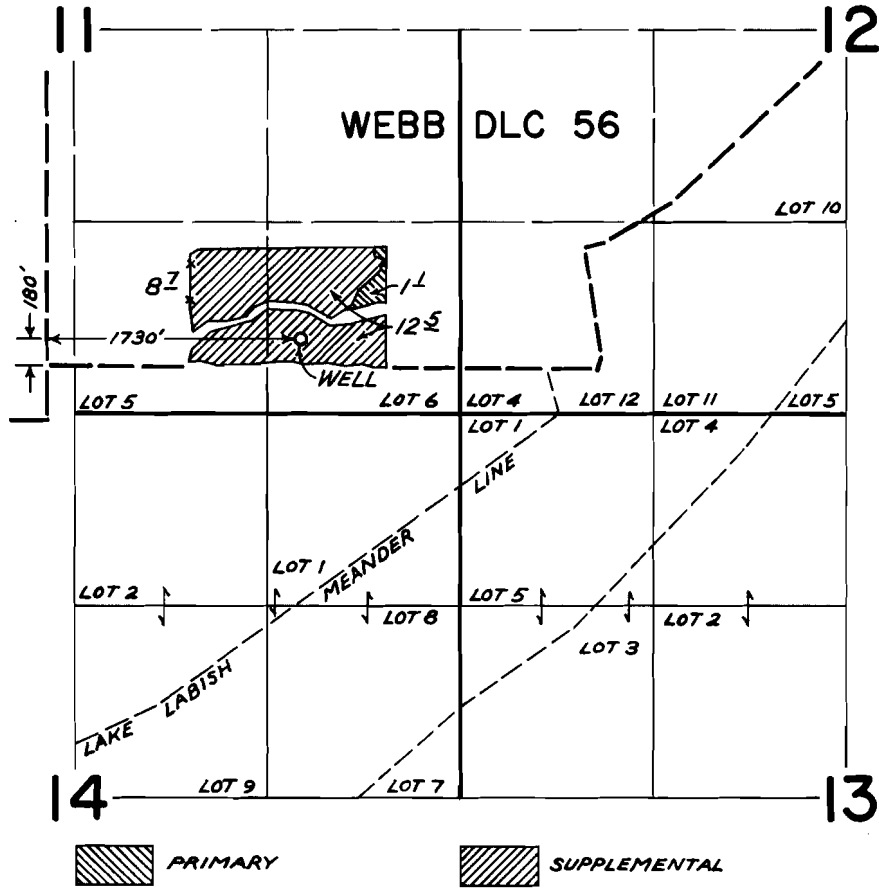

FINAL PROOF SURVEY UNDER

Application No. G-4439 Permit No. G-4182
IN NAME OF

CLYDE REED

Surveyed JULY 29 1971, by GREG BACA