


T. 6 S. R. 2 W. W. M.

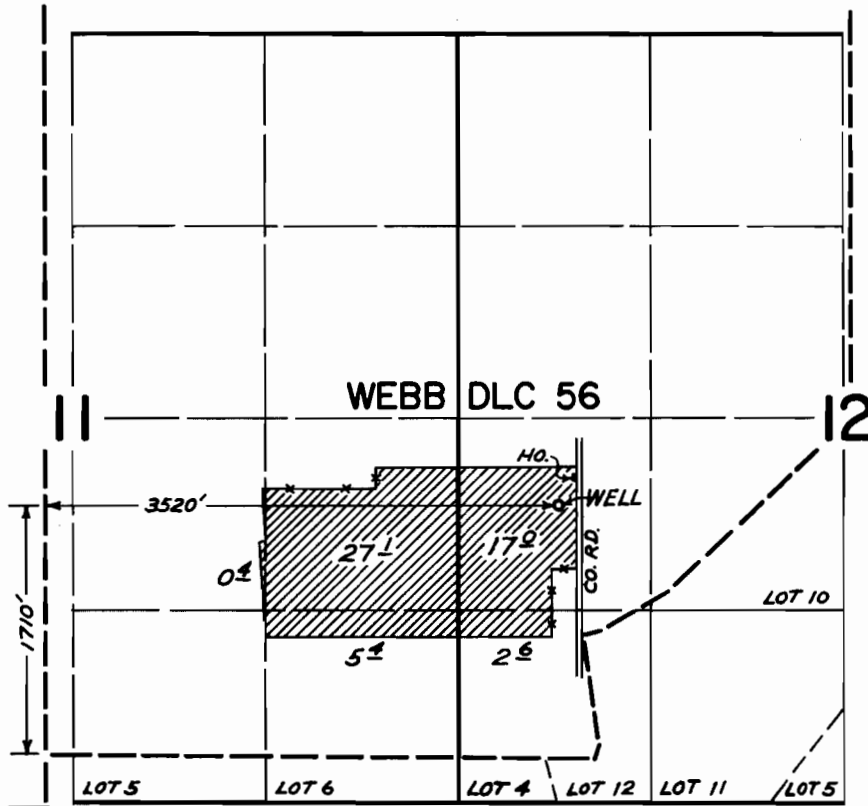

**FINAL PROOF SURVEY**  
UNDER

Application No. G-3762 Permit No. G-3548  
IN NAME OF

TOM JERRY PFAU

Surveyed JULY 30 1971, by GREG BACA