


T. 6 S. R. 2 W. W. M.

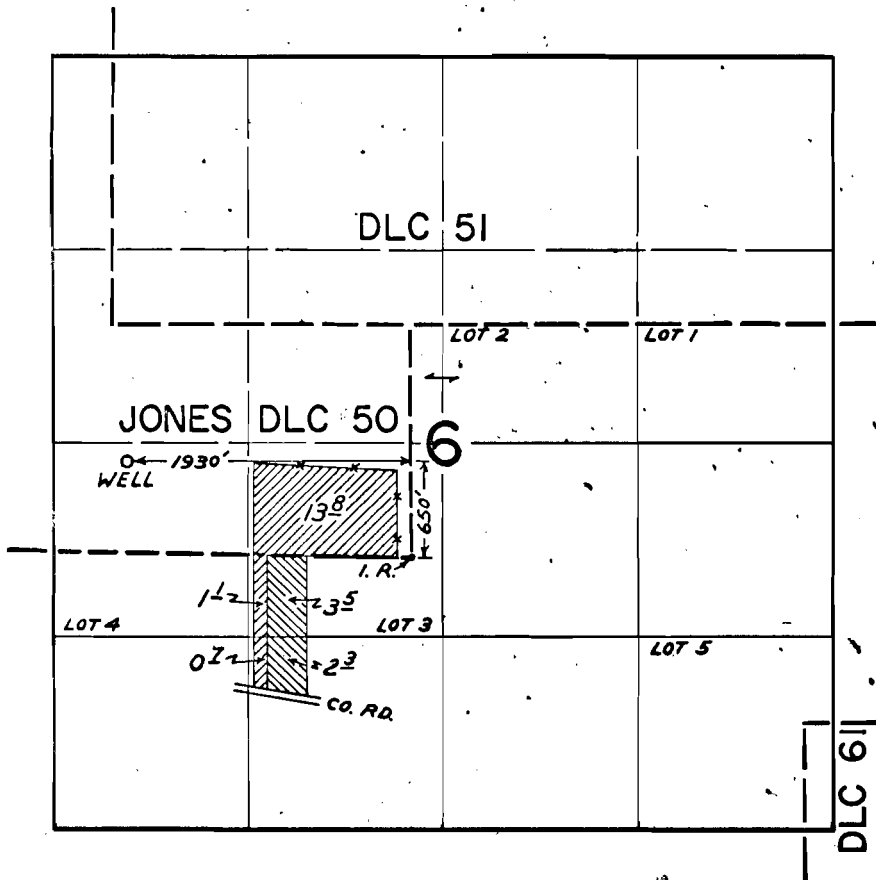

FINAL PROOF SURVEY
UNDER

Application No. G-4264 Permit No. G-4016
G-4743 G-4463

IN NAME OF

TED V. BELL

Surveyed SEPT. 10 1971, by GREG BACA