


T.8S.R.4W. W.M.

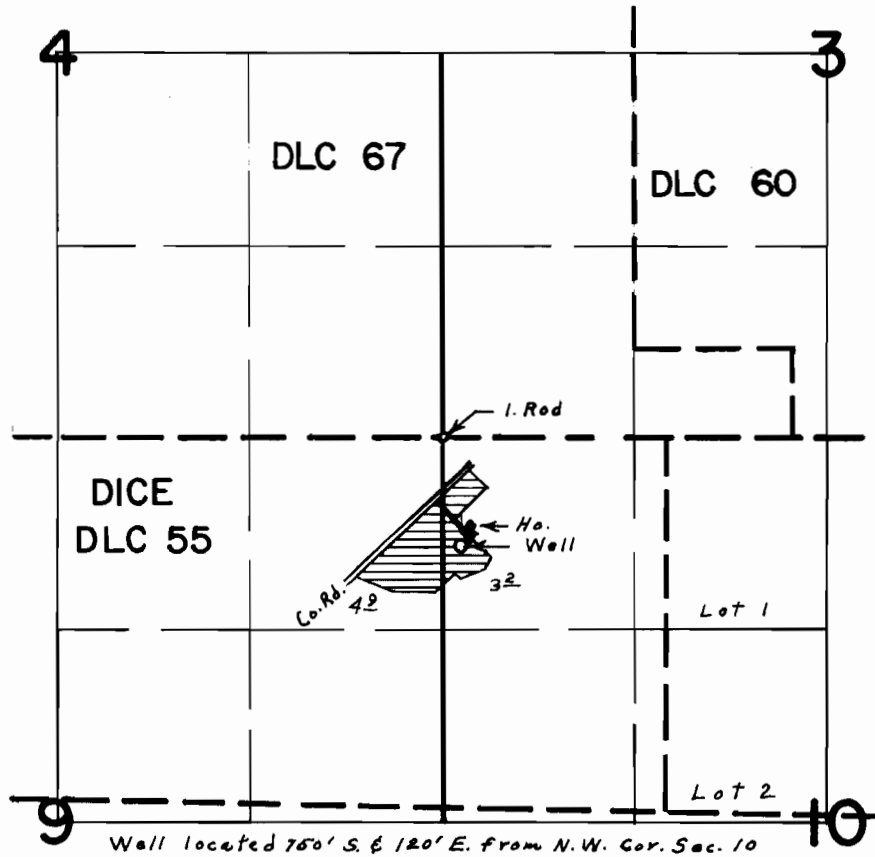

**FINAL PROOF SURVEY**  
UNDER

Application No. G-3636 Permit No. G-3418  
IN NAME OF

DONALD G. BISBEE, LOIS J. BISBEE

Surveyed NOV 10 1972, by L. GOULD