


T.8S.R.4W.W.M.

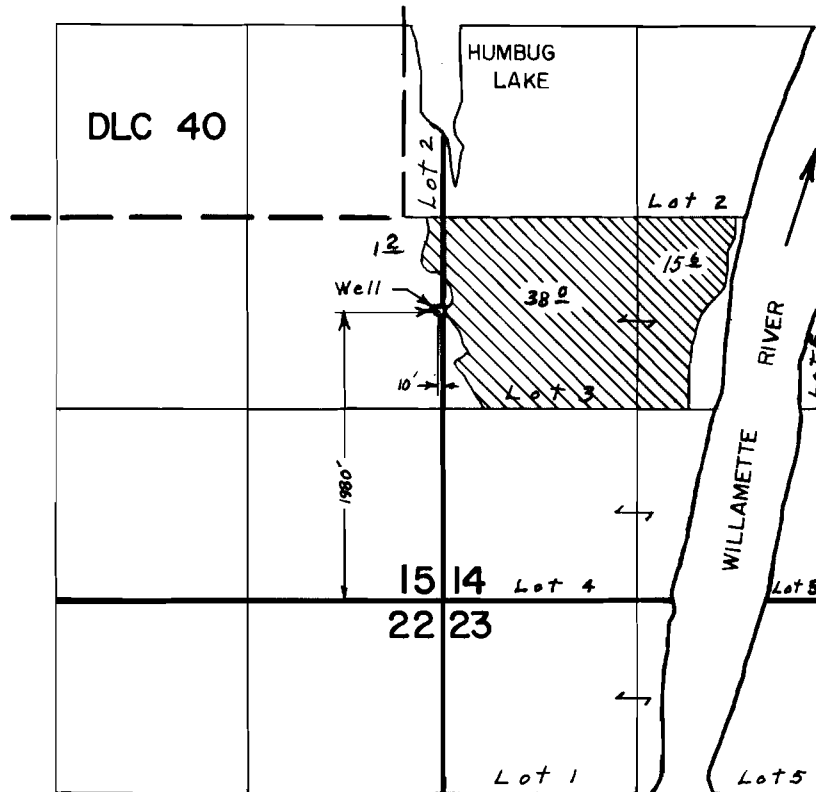

FINAL PROOF SURVEY UNDER

Application No. G-5059 Permit No. G-4769
IN NAME OF

JOHN N. HOOPER

Surveyed NOV 10 1972, by L. GOULD.