


# T.8S.R.5W. W.M.

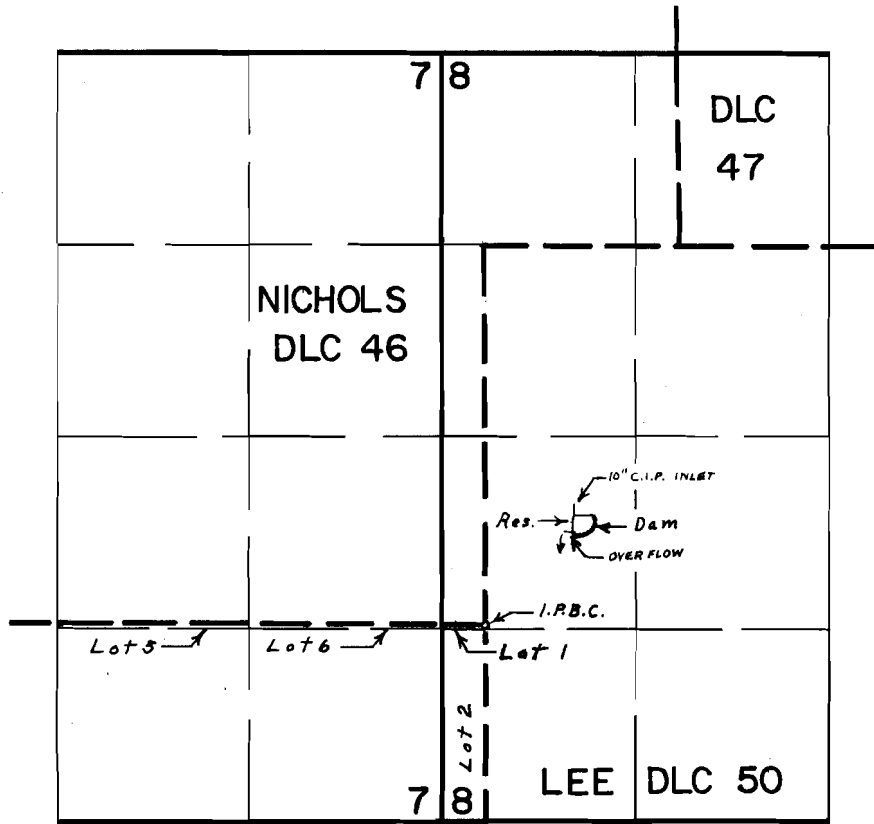

Div. Pt. located 610' N. & 610' E. From S.E. Cor. Nichols D.L.C.46

## FINAL PROOF SURVEY UNDER

Application No. R-47711 Permit No. R-5762  
IN NAME OF

ALBERT KINSEY & GENEVIEVE KINSEY

Surveyed NOV 9 1972, by L. GOULD