


T. 6 S., R. 6 W., W.M.

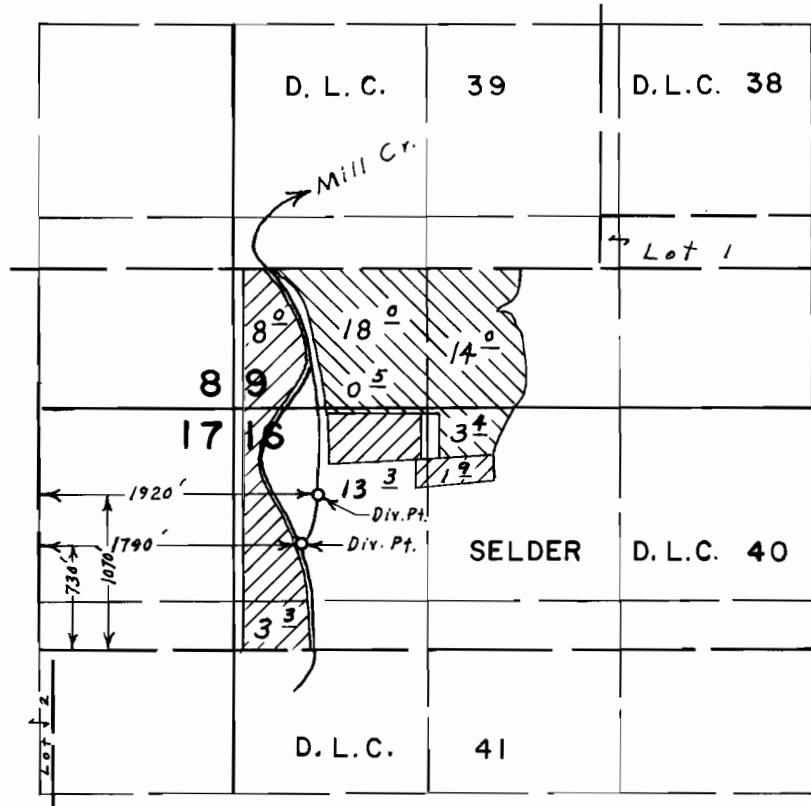

FINAL PROOF SURVEY UNDER

Application No. 42974 Transfer 2519 Permit No. 32106
IN NAME OF

TOIVO J. SIMONSON

Surveyed May 25, 1972, by L. E. Gould.