


T. 8 S. R. 5 W. W.M.

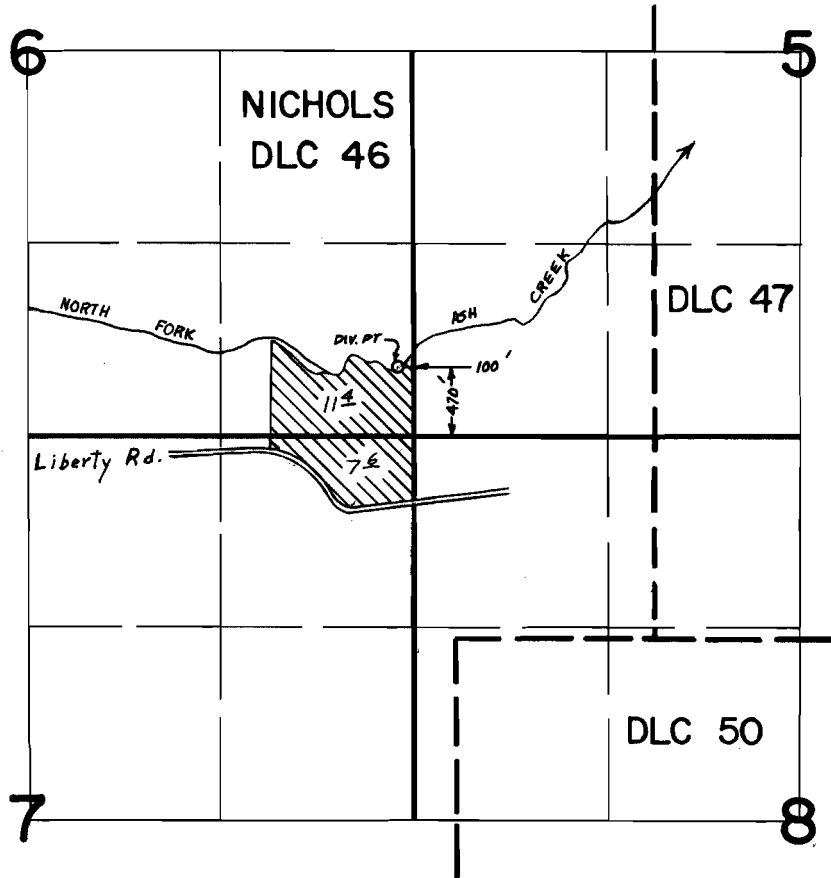

FINAL PROOF SURVEY UNDER

Application No. 44525 Permit No. 33316
IN NAME OF

A. F. TROM

Surveyed NOV 15 1972, by L. GOULD