


T. 6 S., R. 6 W., W.M.

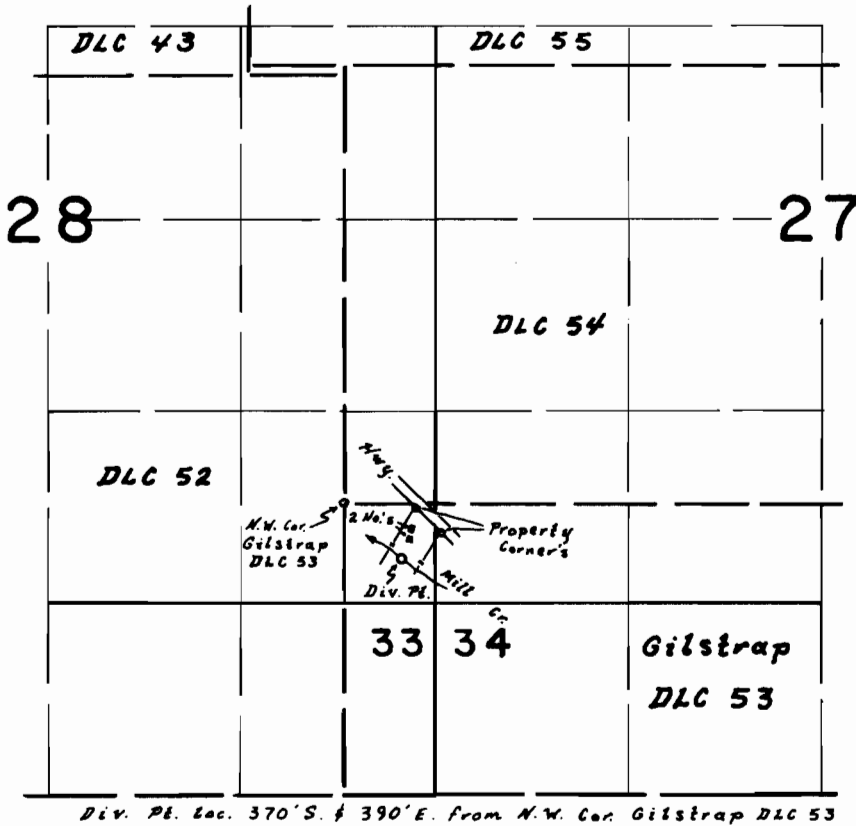

**FINAL PROOF SURVEY**  
UNDER

Application No. 46709 Permit No. 34905  
IN NAME OF

WILLIAM M. VAUGHN

Surveyed May 24, 1972, by L. E. Gould