


T. 6 N. R. 35 E. W. M.

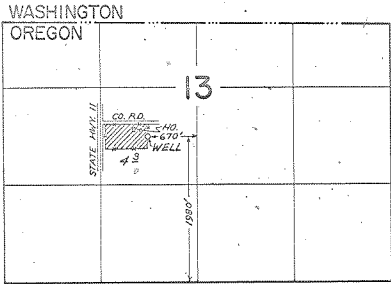

FINAL PROOF SURVEY UNDER

Application No. G-2412..... Permit No. G-2358.....
IN NAME OF
GEORGE H. WHITE

Surveyed MAY 10, 1971., by GREG BACA.....