


Per 4325
3904

OFFICE OF STATE ENGINEER
RECEIVED
OCT 9 1919
S. J. & Co.


Land to be irrigated

Done by G. H. Nelson
Oct 4 1919

Scale 2 in 1 mi

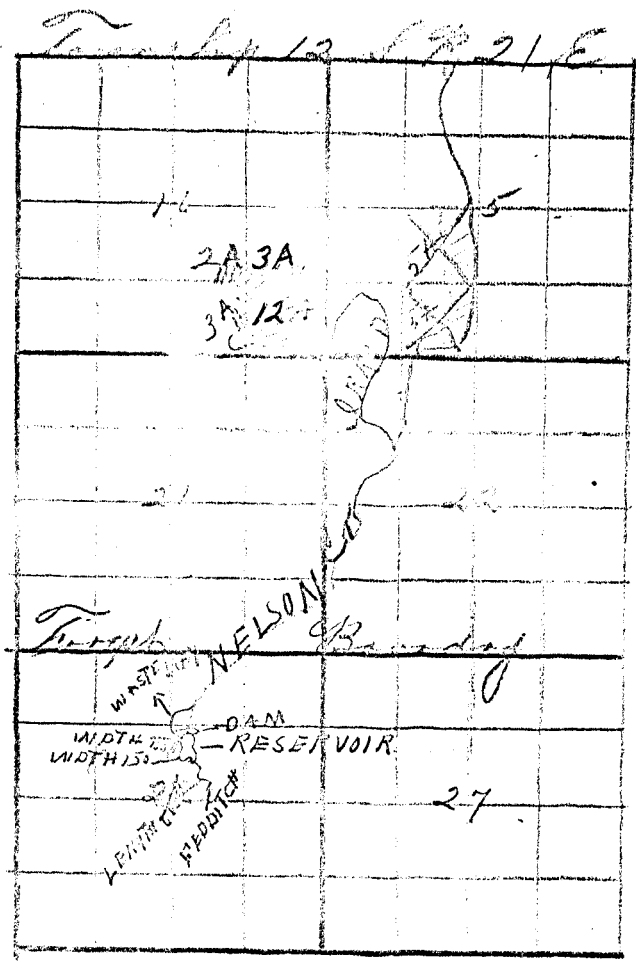

Application No. 6806
Permit No. 4325

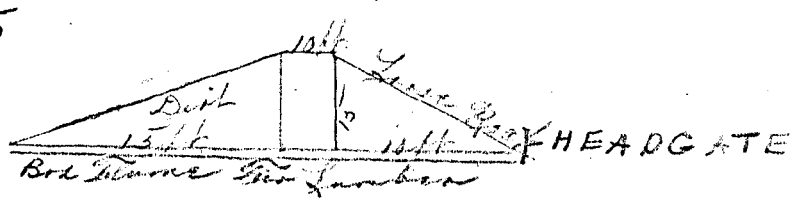

I G. H. Nelson of Mitchell Oregon do hereby certify that this map
was made from notes taken during an actual survey made by me on
Oct 4 1919 & correctly represents the described works.
G. H. Nelson