


# T. 1 S. R. 12 E. W. M

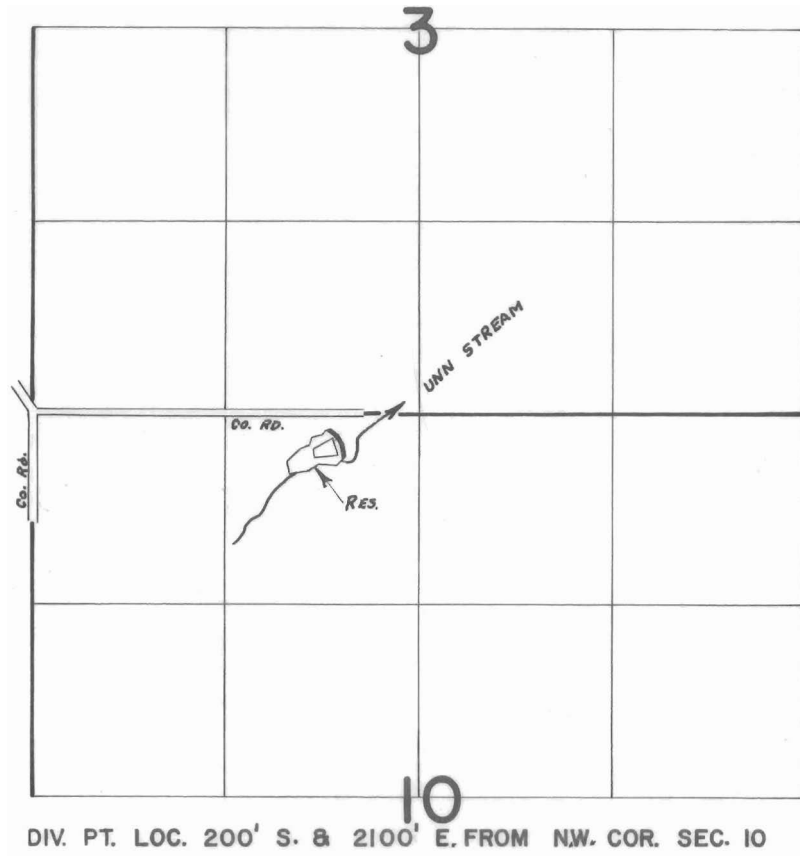

## FINAL PROOF SURVEY UNDER

Application No. R-44392 Permit No. R-5143...  
IN NAME OF

MR. & MRS. EDWIN LIECHTI

Surveyed NOV. 9, 1971, by L. E. Gould