


PT 51066

# T. 1 S. R. 13 E. W. M.

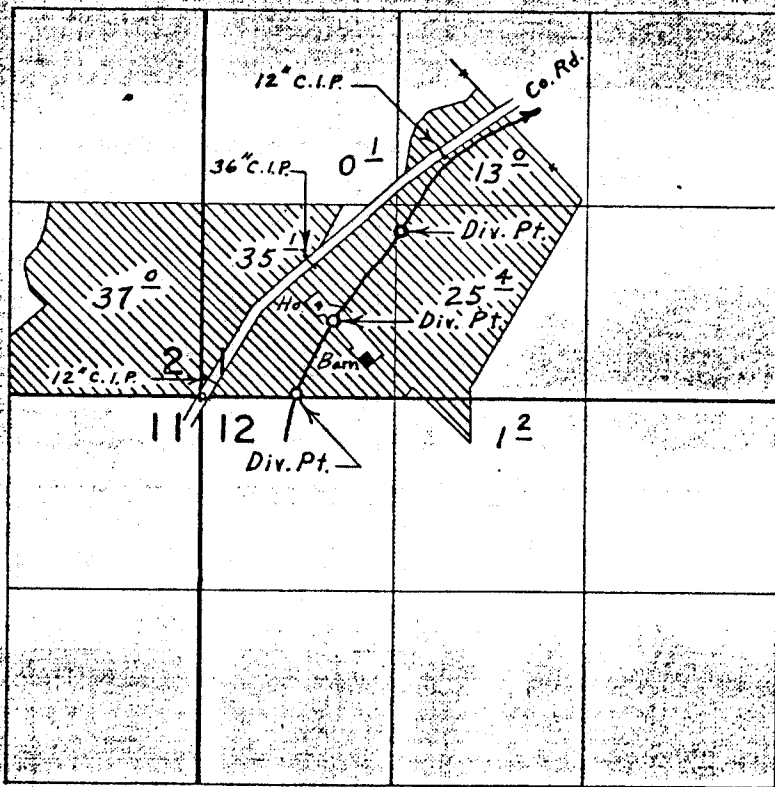

Div. Pts. located: 1140' N. & 1360' E.; 520' N. & 900' E.; 20' N. & 640' E.; all from S.W. Cor. Sec. 1

## FINAL PROOF SURVEY UNDER

Application No. 41600 Permit No. 31028  
IN NAME OF  
FRANK K. MAY

Surveyed Nov. 11, 1971, by L. E. Gould