


T. 2 N. R. 4 W. W. M.

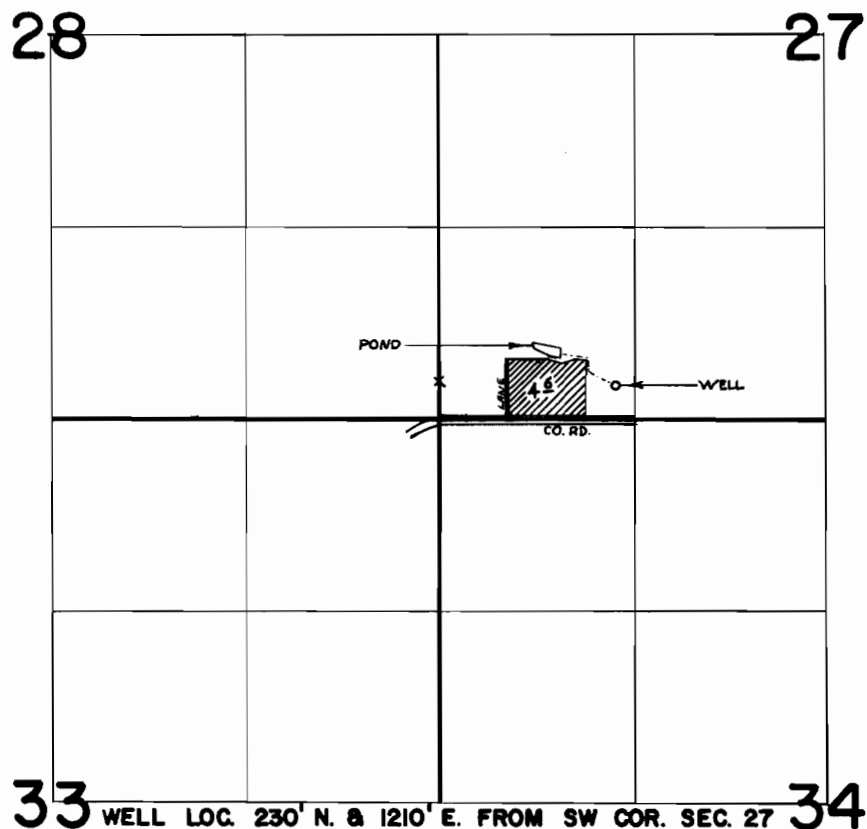

**FINAL PROOF SURVEY**  
UNDER

Application No. G. 3968 Permit No. G. 3726  
IN NAME OF

DAYBREAK NURSERY - DOUGLAS E. SABIN

Surveyed JUNE 15, 1971, by R. MUCKEN