


T. 3 S. R. 4 W. W. M.

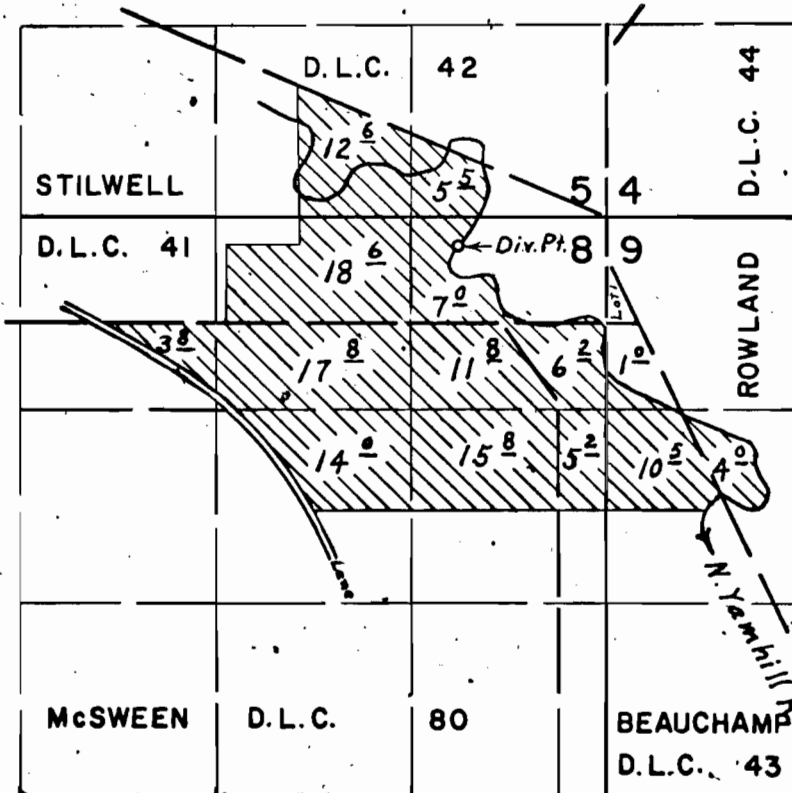

Div. Pt. located 200' S. & 1000' W. from N.E. Cor. Sec. 8

FINAL PROOF SURVEY UNDER

Application No. 41736 Permit No. 31158
IN NAME OF

ROBERT VAN DYKE

Surveyed Oct. 26, 1971, by L. E. Gould