


# T. 3 S. R. 4 & 5 W. W. M.

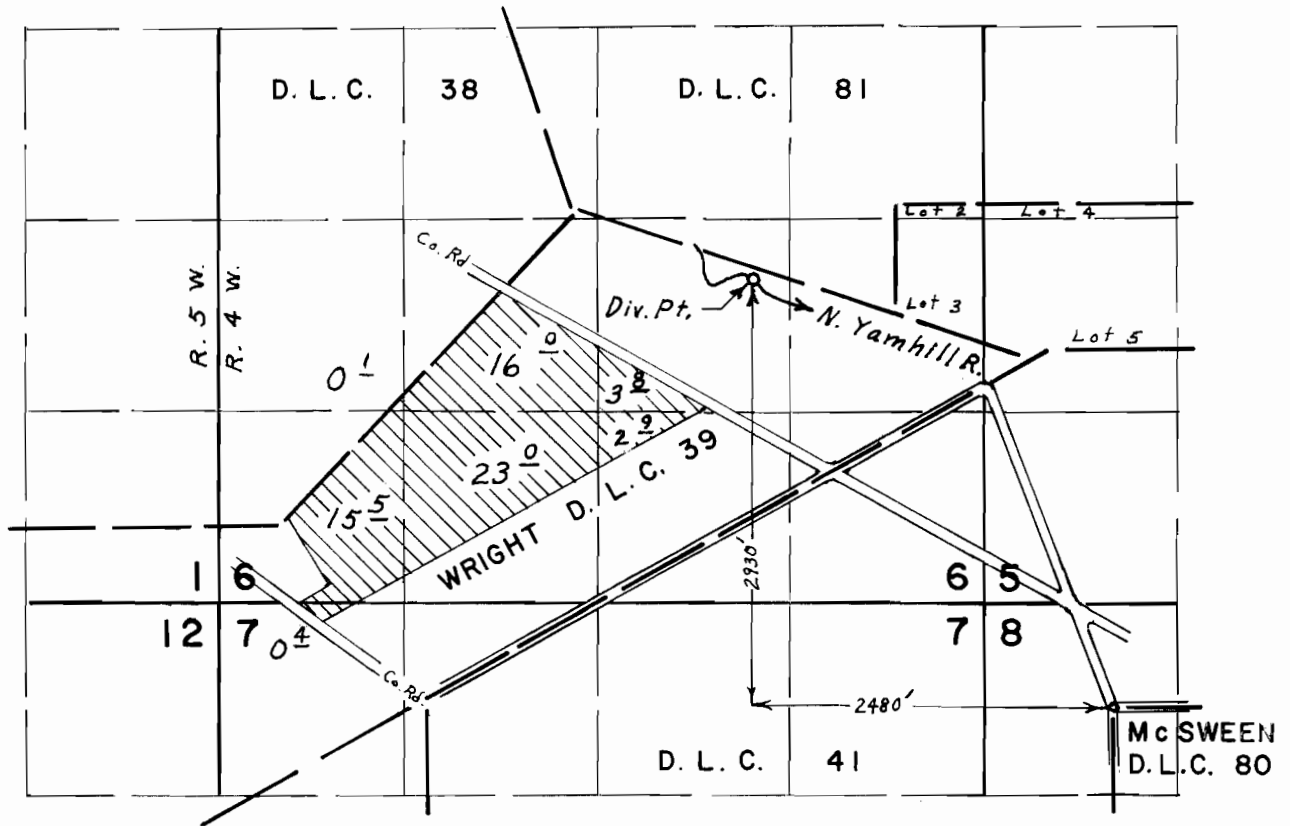

## FINAL PROOF SURVEY UNDER

Application No. 41927 Permit No. 31385  
IN NAME OF

MARK FIDEL

Surveyed Oct. 27, 1971, by L. E. Gould