


# T. 3 S. R. 4 & 5 W. W. M.

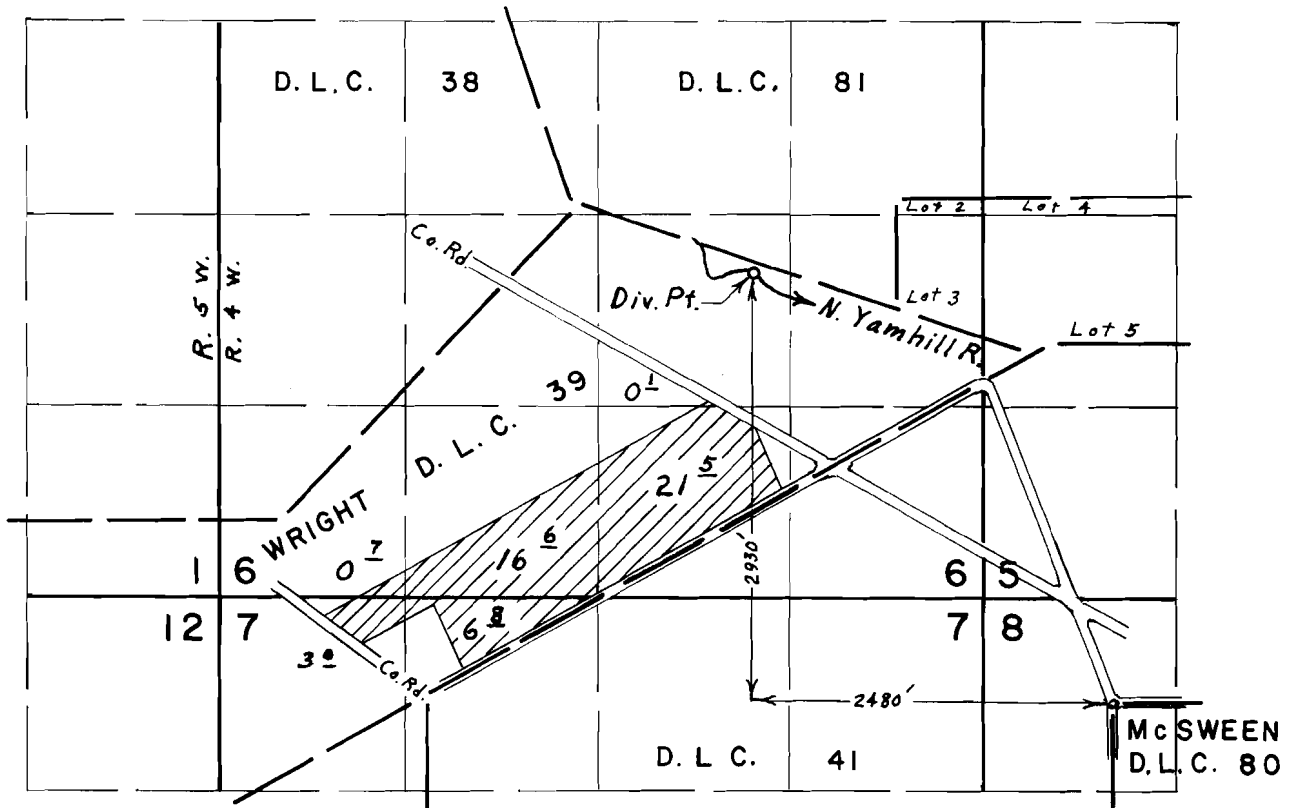

## FINAL PROOF SURVEY UNDER

Application No. 45639 Permit No. 34035  
IN NAME OF

**FIDEL BROS.**

Surveyed Oct. 27, 1971, by L. E. Gould