


# T. 3 S. R. 4 W. W. M.

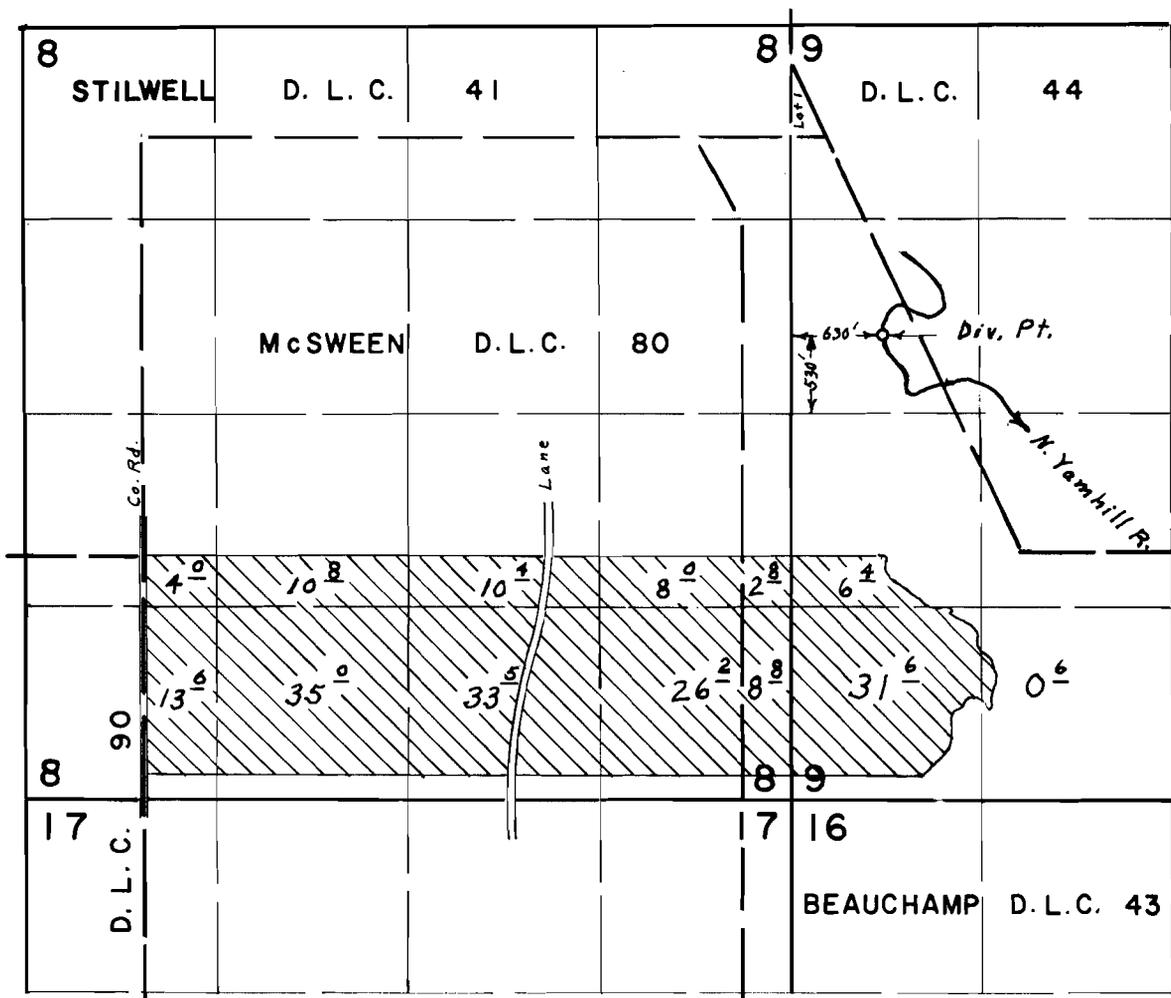

## FINAL PROOF SURVEY UNDER

Application No. 45641 Permit No. 34037  
IN NAME OF

FIDEL BROS.

Surveyed Oct. 26, 1971, by L. E. Gould