


T. 5 S. R. 5 W. W. M.

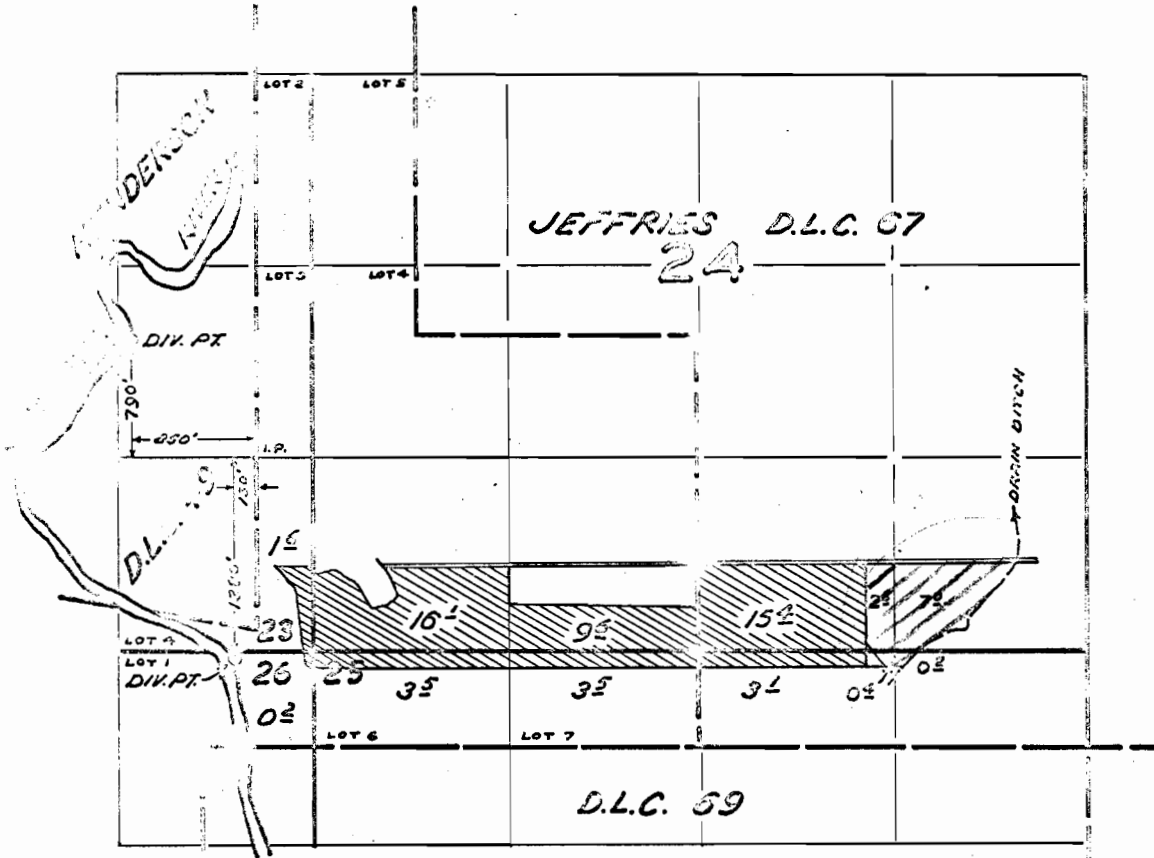

FINAL PROOF SURVEY
UNDER

Application No. 40398 Permit No. 30123
IN NAME OF

D. F. HOWARD

Surveyed AUG. 2 1965, by R. JACKSON