


T.58&6 S.R.5&6 W.W.M.

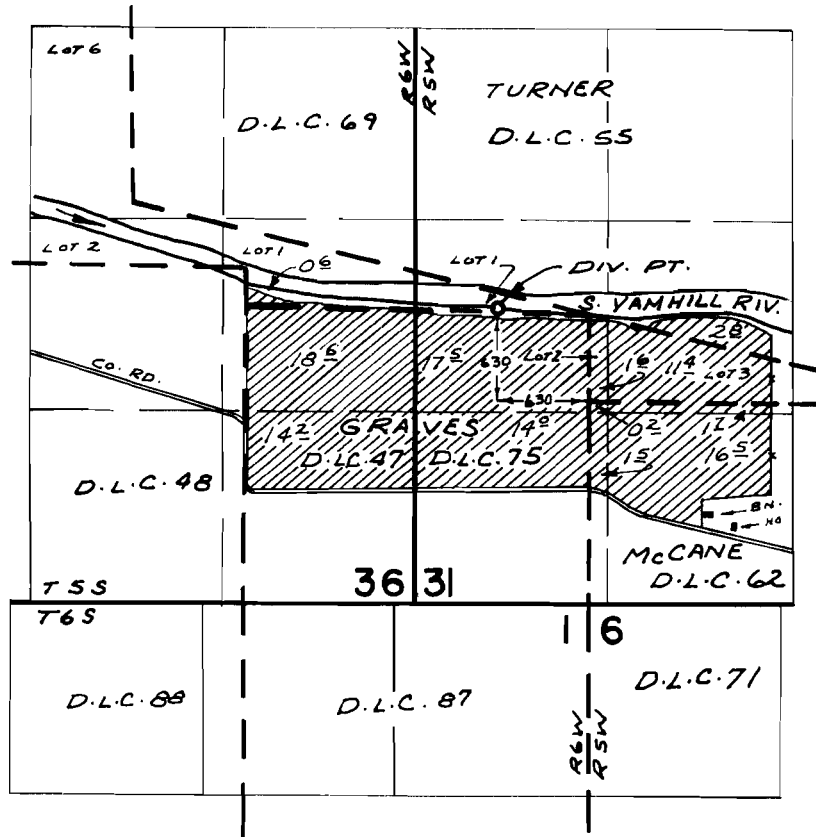

FINAL PROOF SURVEY UNDER

Application No. 46441... Permit No. 34700...
IN NAME OF

OTTO P. BRANDT

Surveyed FEB. 2, 1973, by R. MUCKEN