


T. 78 S. R. 46 E. W.M.

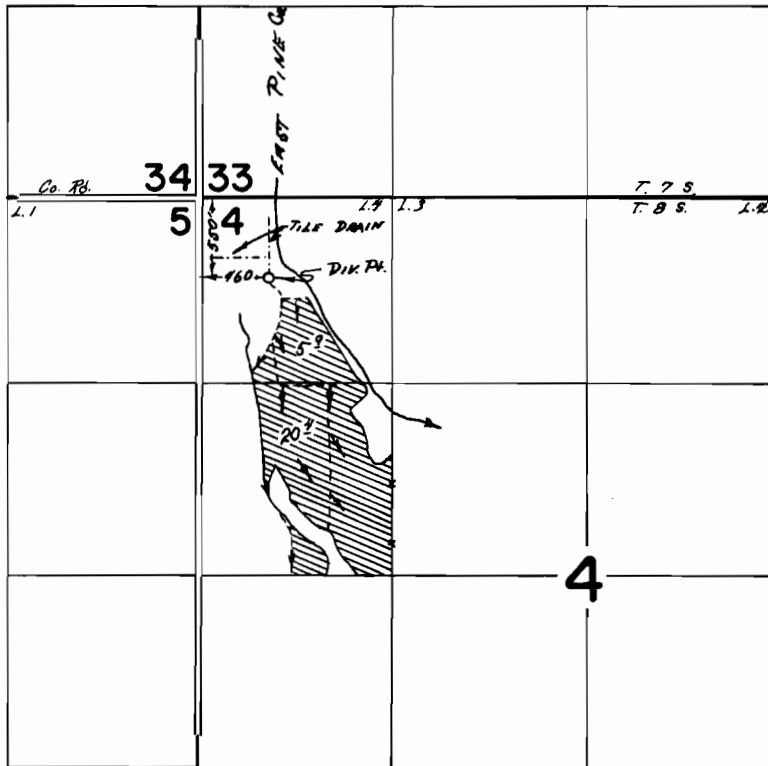

FINAL PROOF SURVEY
UNDER

Application No. G-3326 Permit No. G-3126
IN NAME OF

FRANK HUFF

Surveyed JUNE 24 19 72, by R. G. MUCKEN