


T. 7 S. R. 39 E. W. M.

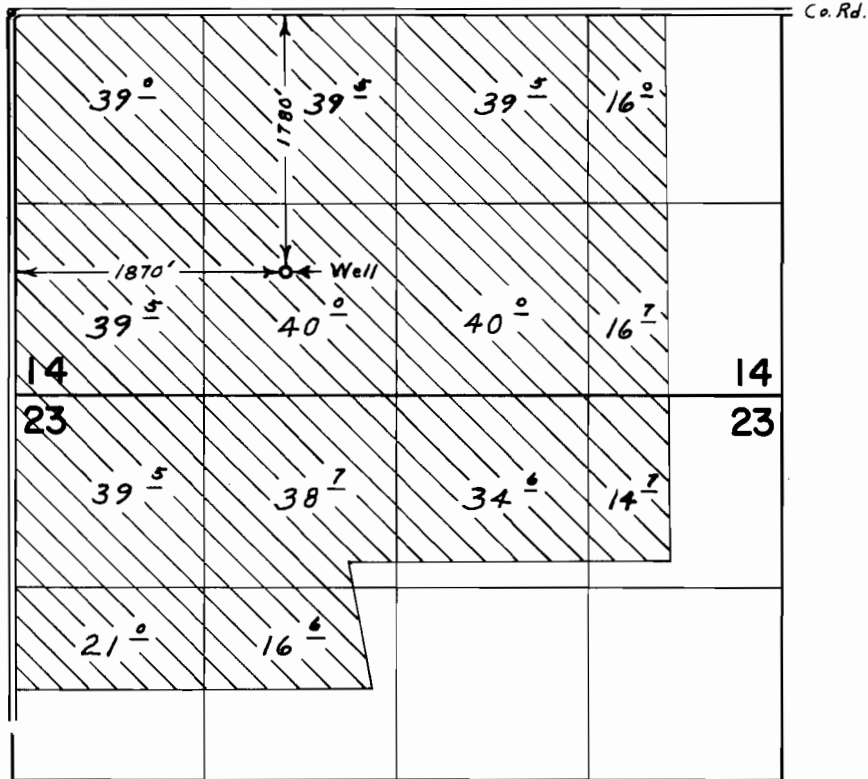

FINAL PROOF SURVEY UNDER

Application No. G-3278 Permit No. G-3162

RICHARD B. CARLYN & ALEXANDER

Surveyed May 14, 1970, by L. E. Gould