


T. 8 S., R. 39 E., W.M.

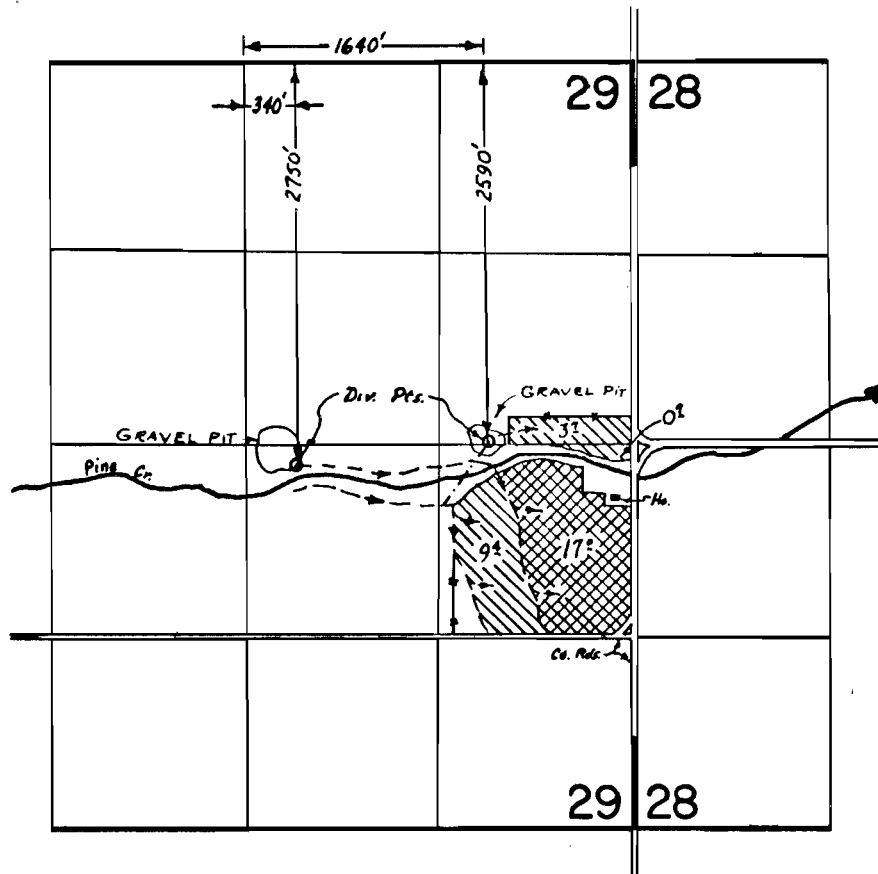

FINAL PROOF SURVEY
UNDER

Application No. G-5547 Permit No. G-4953 
G-4088 G-3840
IN NAME OF

JAMES W. COLEMAN

Surveyed Oct. 18 1972, by R.G. Mucken