


T. 8 S., R. 39 E., W.M.

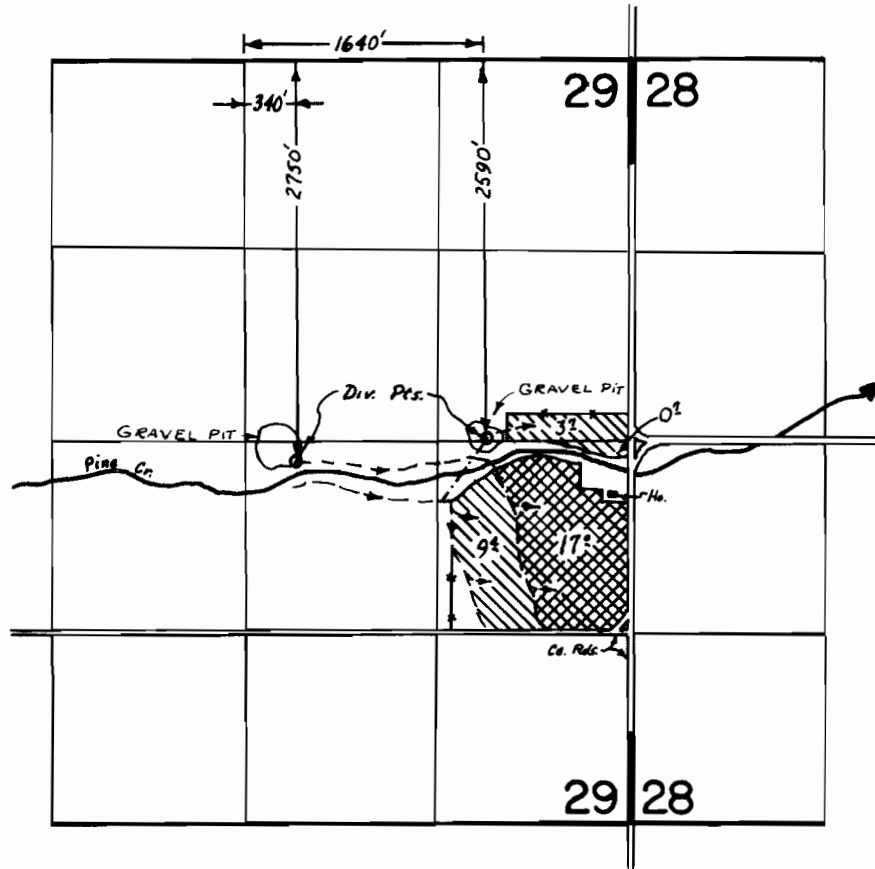

FINAL PROOF SURVEY
UNDER

G-5547 G-4953
Application No. G-4088 Permit No. G-3840
IN NAME OF

JAMES W. COLEMAN

Surveyed Oct. 18, 1972, by R.G. Mucken