


T.7S. R.48E. W.M.

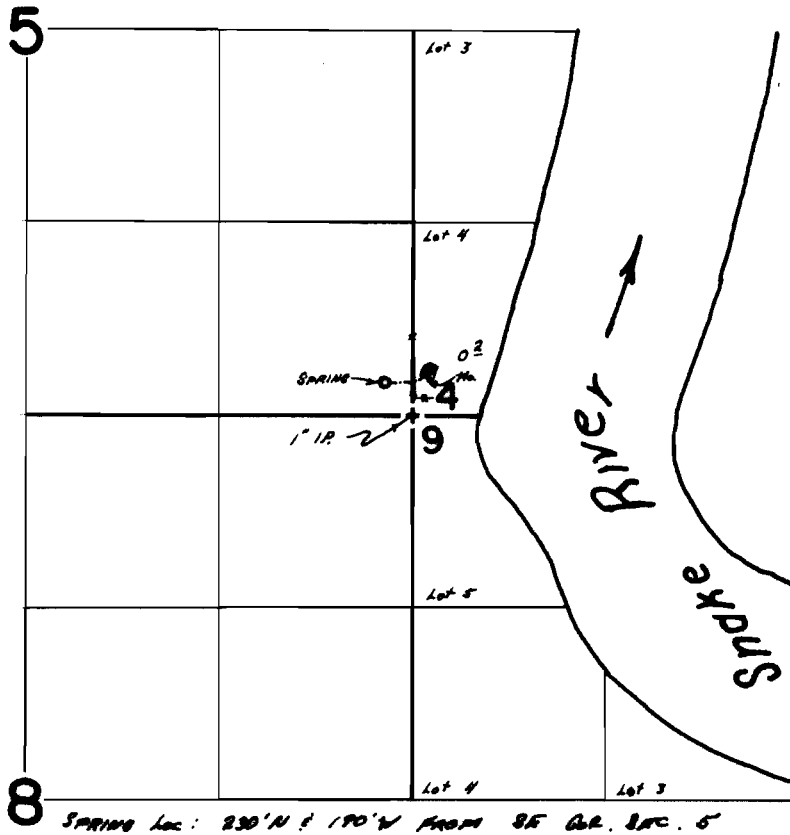

**FINAL PROOF SURVEY**  
UNDER

Application No. 41257 Permit No. 30765  
IN NAME OF

JAMES W. ZANELLI

Surveyed June 24 1972, by R.B. MUCKEN