


# T.4 N.R.9W.W.M.

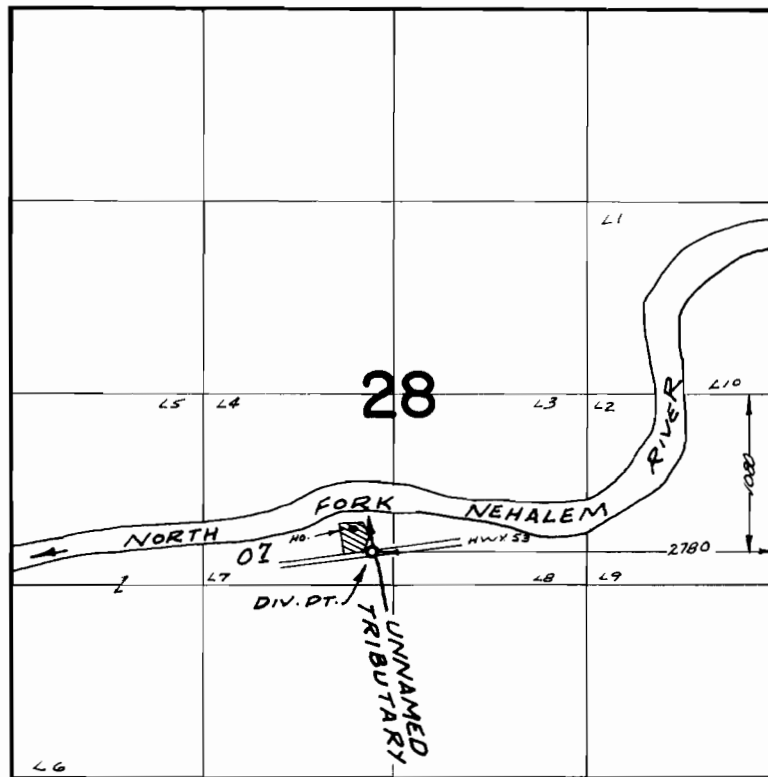

## FINAL PROOF SURVEY UNDER

Application No. 41669 Permit No. 30876  
IN NAME OF

JOHN E. MUNHALL

Surveyed JULY 22, 1971, by G. BACA