


T. 24 & 25 S. R. 11 W. W. M.

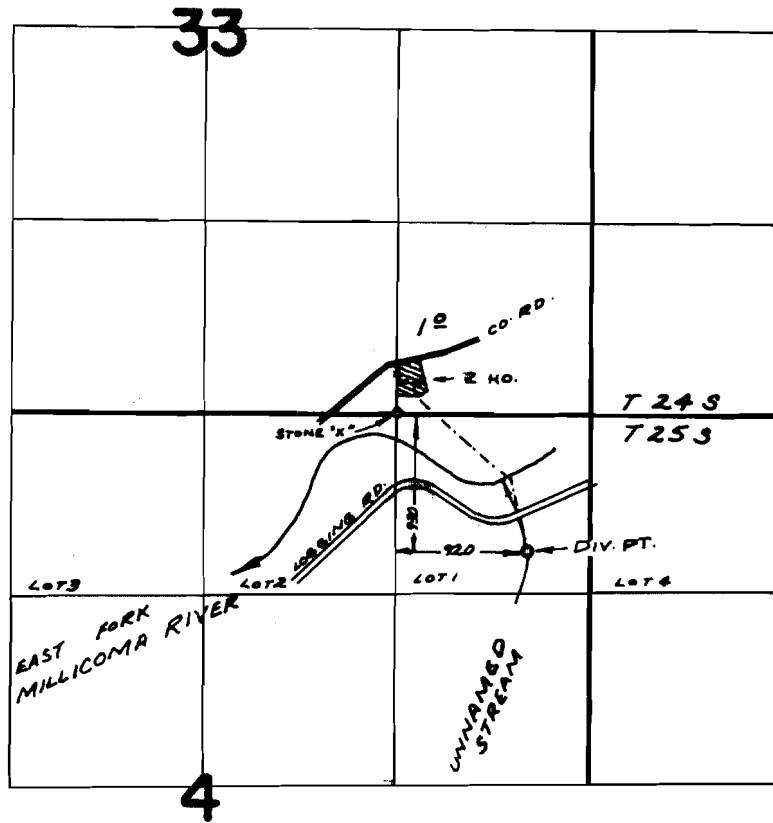

FINAL PROOF SURVEY UNDER

Application No. 91,967 Permit No. 31225
IN NAME OF

VAND HILL & HERBERT BIRD

Surveyed AUG. 1 1972, by R. MUCKEN