

T.7S, R26E, W.M.

7


STORAGE TANK

PIPE LINE

SPRING

469' N

SECTION CORNER MARKED

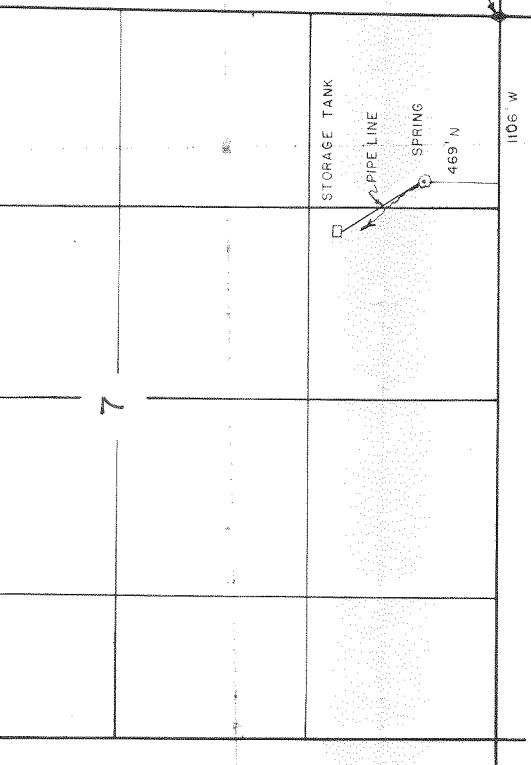

SECTION CORNER MARKED
BY PILE OF ROCKS BY
JUNIPER TREE

1106' W

STORAGE TANK

PIPE LINE

SPRING

469' N

YEARLING SPRING

SCALE 8" = 1 MILE

9/10/60

570

24389
27057