


39130 29208

DEPARTMENT OF AGRICULTURE
FOREST SERVICE
FIELD MAP SHEET

Scale 4 inches = 1 mile
T. 11S. R. 34E. Sec. 33
Mag. Dec. 20° Acres —

MALHEUR N.F.
BLUE MTN. R.D.
WATER RIGHTS
(Case designation)

Unit DIXIE SPRING

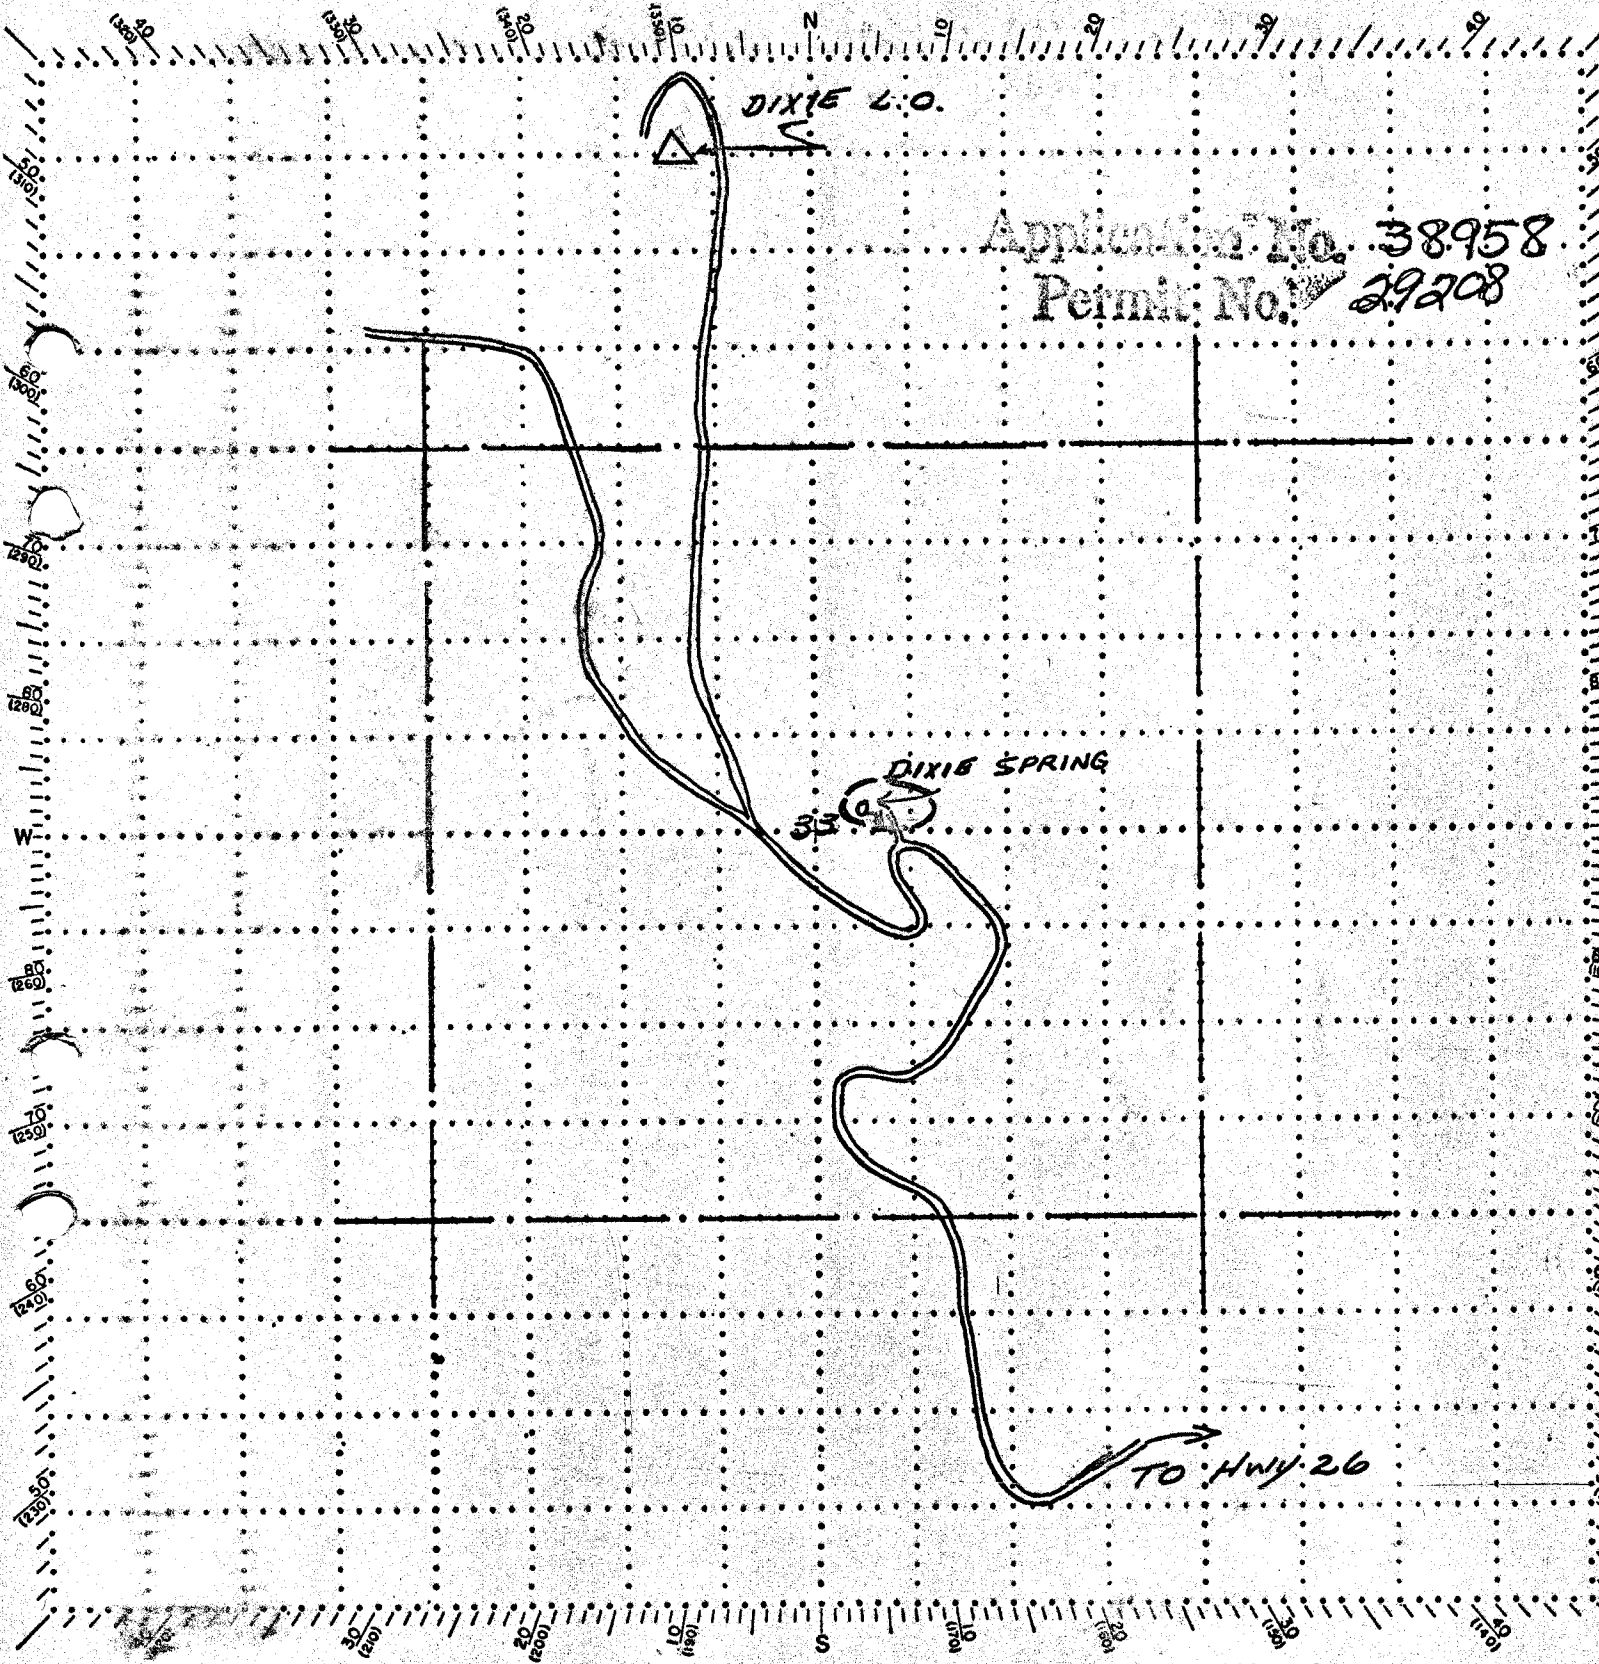

Application No. 38958
Permit No. 29208

Field work by HETZEL Date 7-30-63 Platted by HETZEL

Remarks

Approved _____, 19____

5400-19a (5/48)

U. S. GOVERNMENT PRINTING OFFICE 16-56789-1

Approving Officer, _____