


# T.10S.R.30E.W.M.

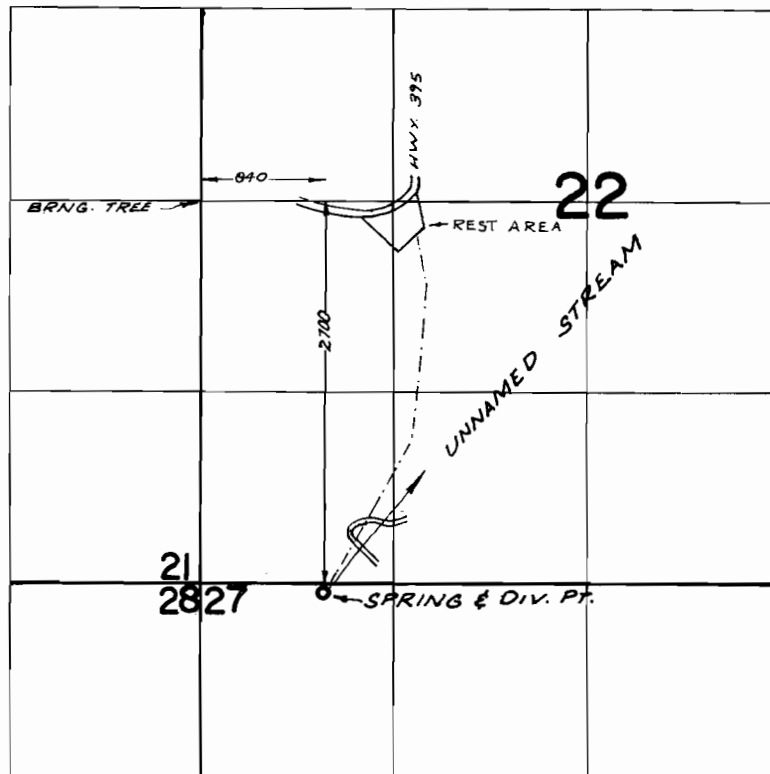

## FINAL PROOF SURVEY UNDER

TRANSFER No. 0-43  
Application No. 40346 Permit No. 30084  
IN NAME OF

STATE of OREGON

Surveyed AUG. 26, 1971, by R. MUCKEN.