


~~6-380~~

6-3587

T.2N.R.10E.W.M.

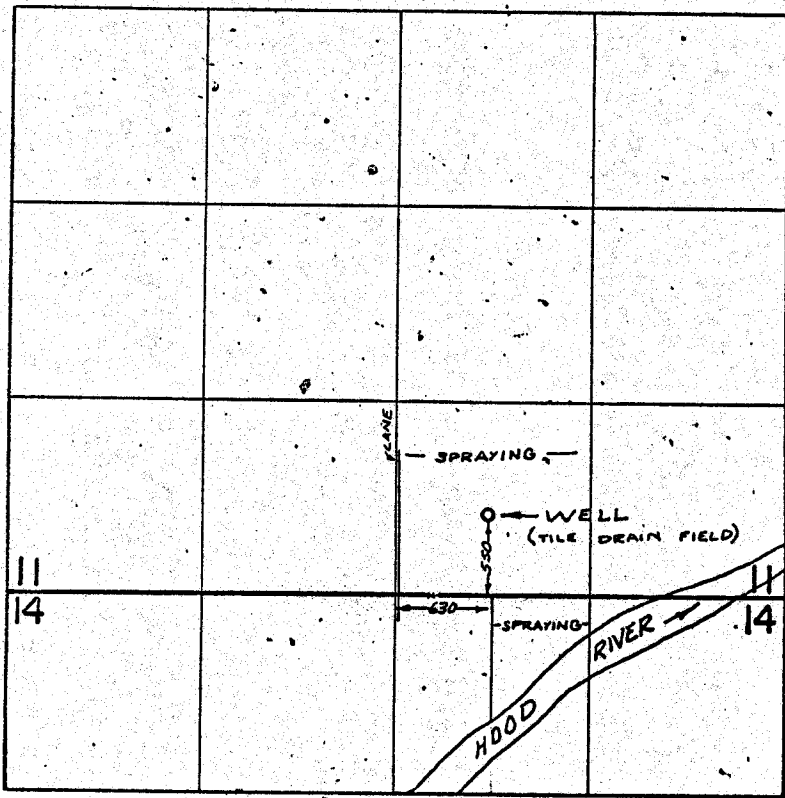

FINAL PROOF SURVEY UNDER

Application No. G-3801 Permit No. G-3587
IN NAME OF

DORRINE M. MAY

Surveyed APR. 22, 1971, by G. BACA

R.G.V.
1971-A