


T.2N.R.10E.W.M.

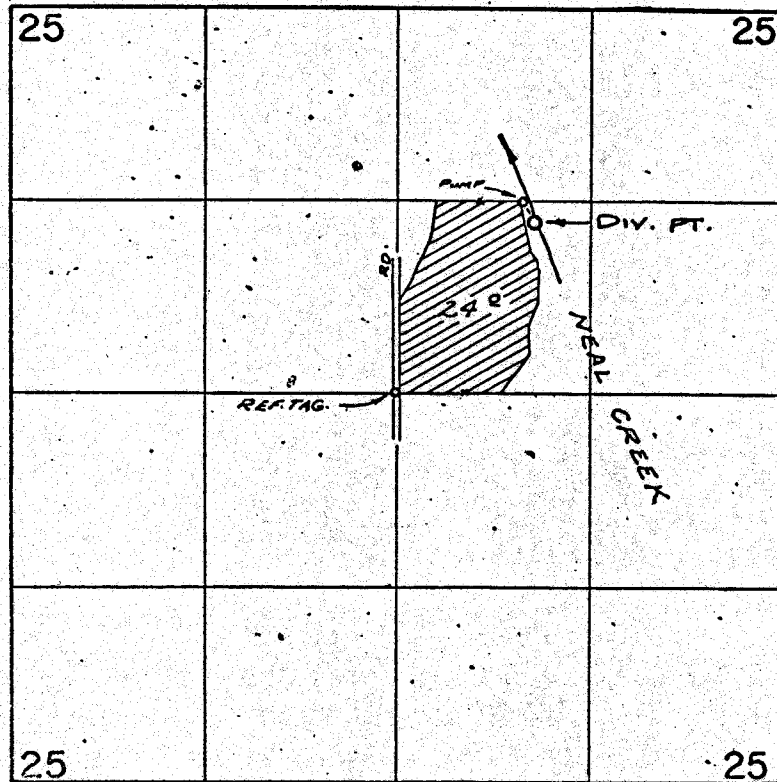

DIV. PT. LOC: 1170' N. & 940' E. FROM CENTER SEC. 25

FINAL PROOF SURVEY UNDER

Application No. 40423... Permit No. 30135...
IN NAME OF

ISAAC W. & NONA MURPHY

Surveyed APR. 21, 1971, by G. BACA