


32663

T.2R.10E.W.M.

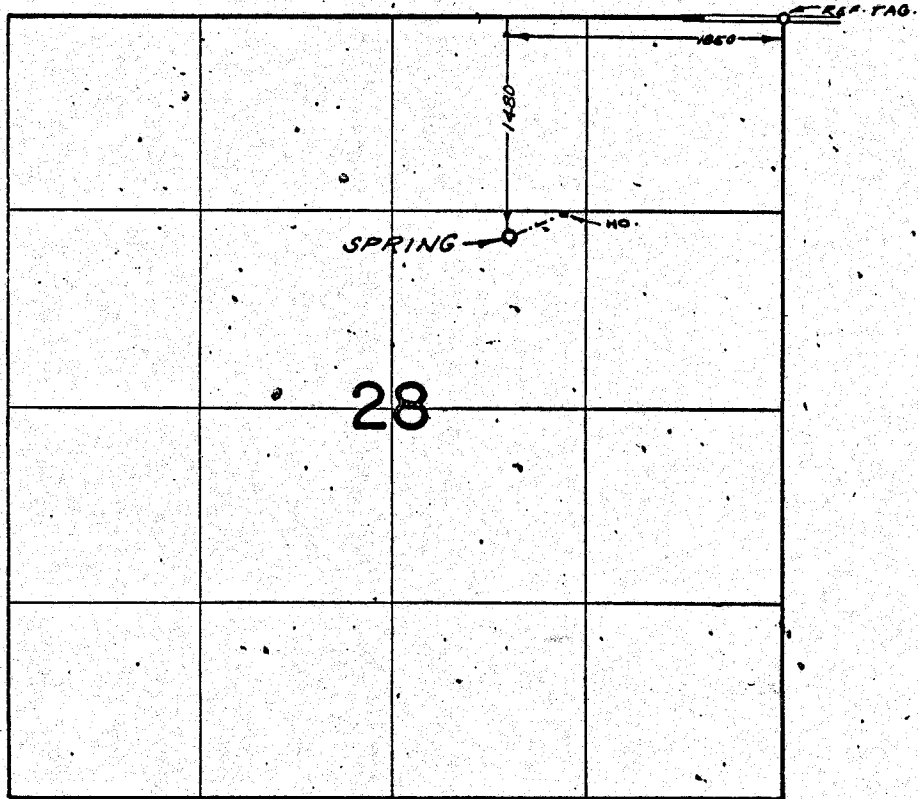

**FINAL PROOF SURVEY**  
UNDER

Application No. 43709 Permit No. 32663  
IN NAME OF

WILLIAM COPERUDE

Surveyed APR. 22, 1971 by G. BACA