


T. 3N. R. 10E. W.M.

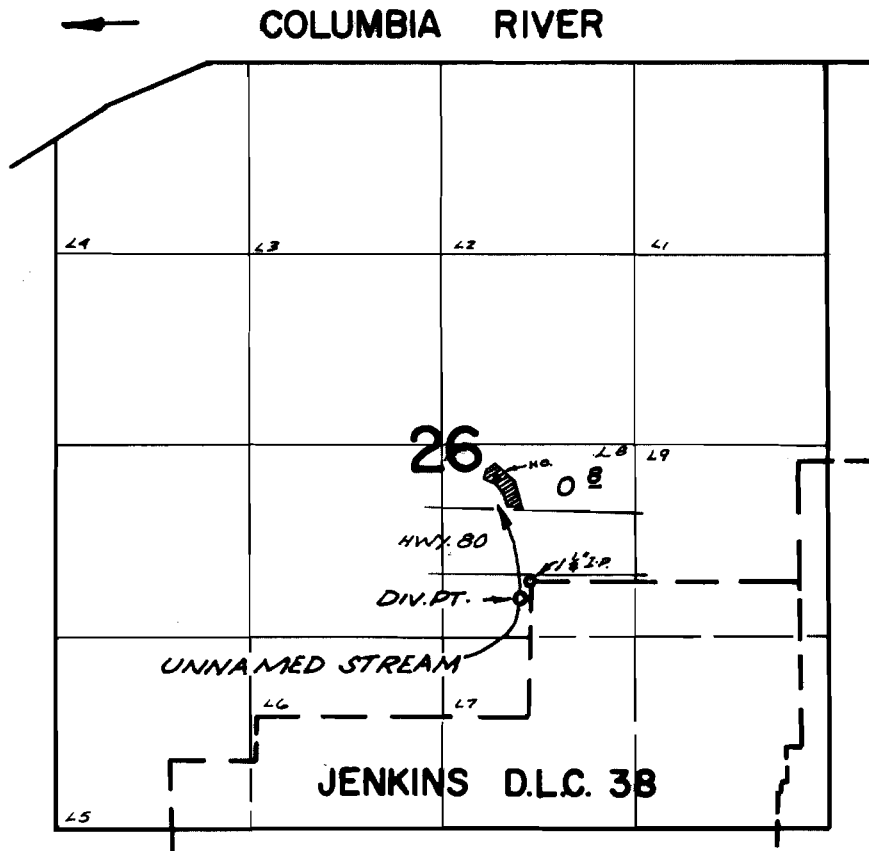

DIV. PT. LOC: 120'S. & 70'W. FROM NORTHERLY N.W. COR.
D.L.C. 38

FINAL PROOF SURVEY UNDER

Application No. 46186 Permit No. 34512
IN NAME OF

DR. STANLEY WELLS

Surveyed APR. 23, 1971, by G. BACA