


T. 38 S. R. 3 E. W. M.

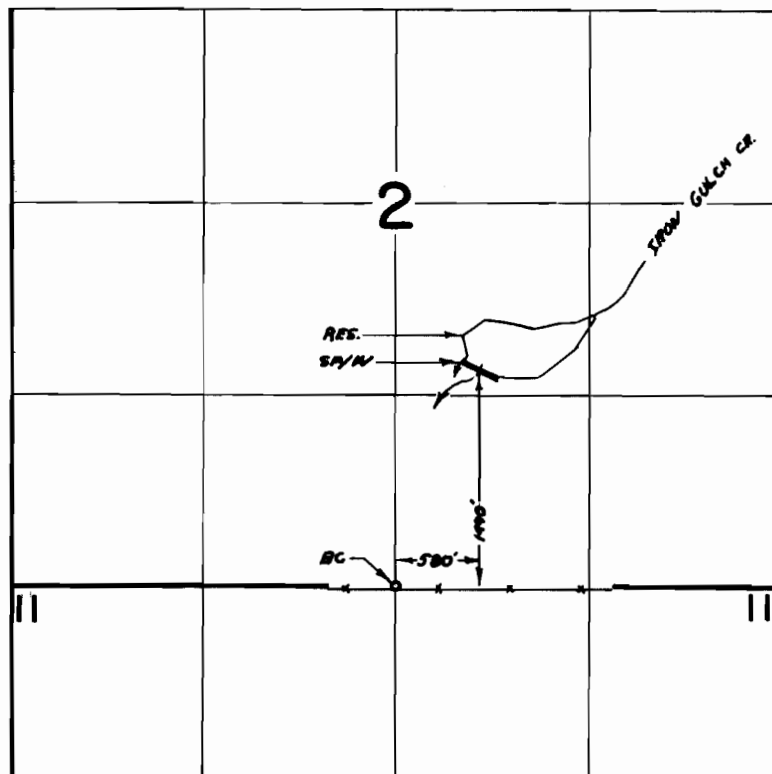

FINAL PROOF SURVEY
UNDER

R - 40103 R - 4138
Application No. 40207 Permit No. 29818
IN NAME OF

.....ELDRED F. CHARLEY.....

Surveyed OCT. 13, 1971, by R. MUCKEN.....