


T.39S., R.8W., W.M.

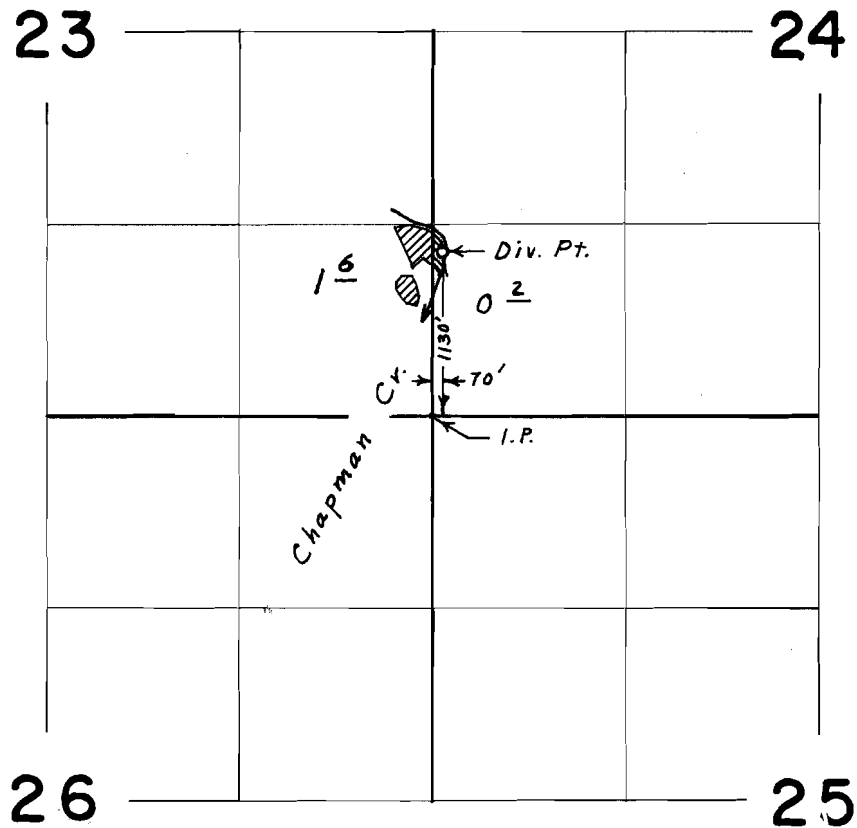

FINAL PROOF SURVEY
UNDER

Application No. 43562 Permit No. 32578
42747 31363 

IN NAME OF
NOLAN W. & JUDITH G. KINER

Surveyed Oct. 27, 1972, by L. E. Gould