

9-7114-1
Nov. 1965

UNITED STATES
DEPARTMENT OF THE INTERIOR
BUREAU OF LAND MANAGEMENT

34170
39144


SECTION

32

Oregon State Water Filings

TOWNSHIP 40S, RANGE 15E, W. M.

North

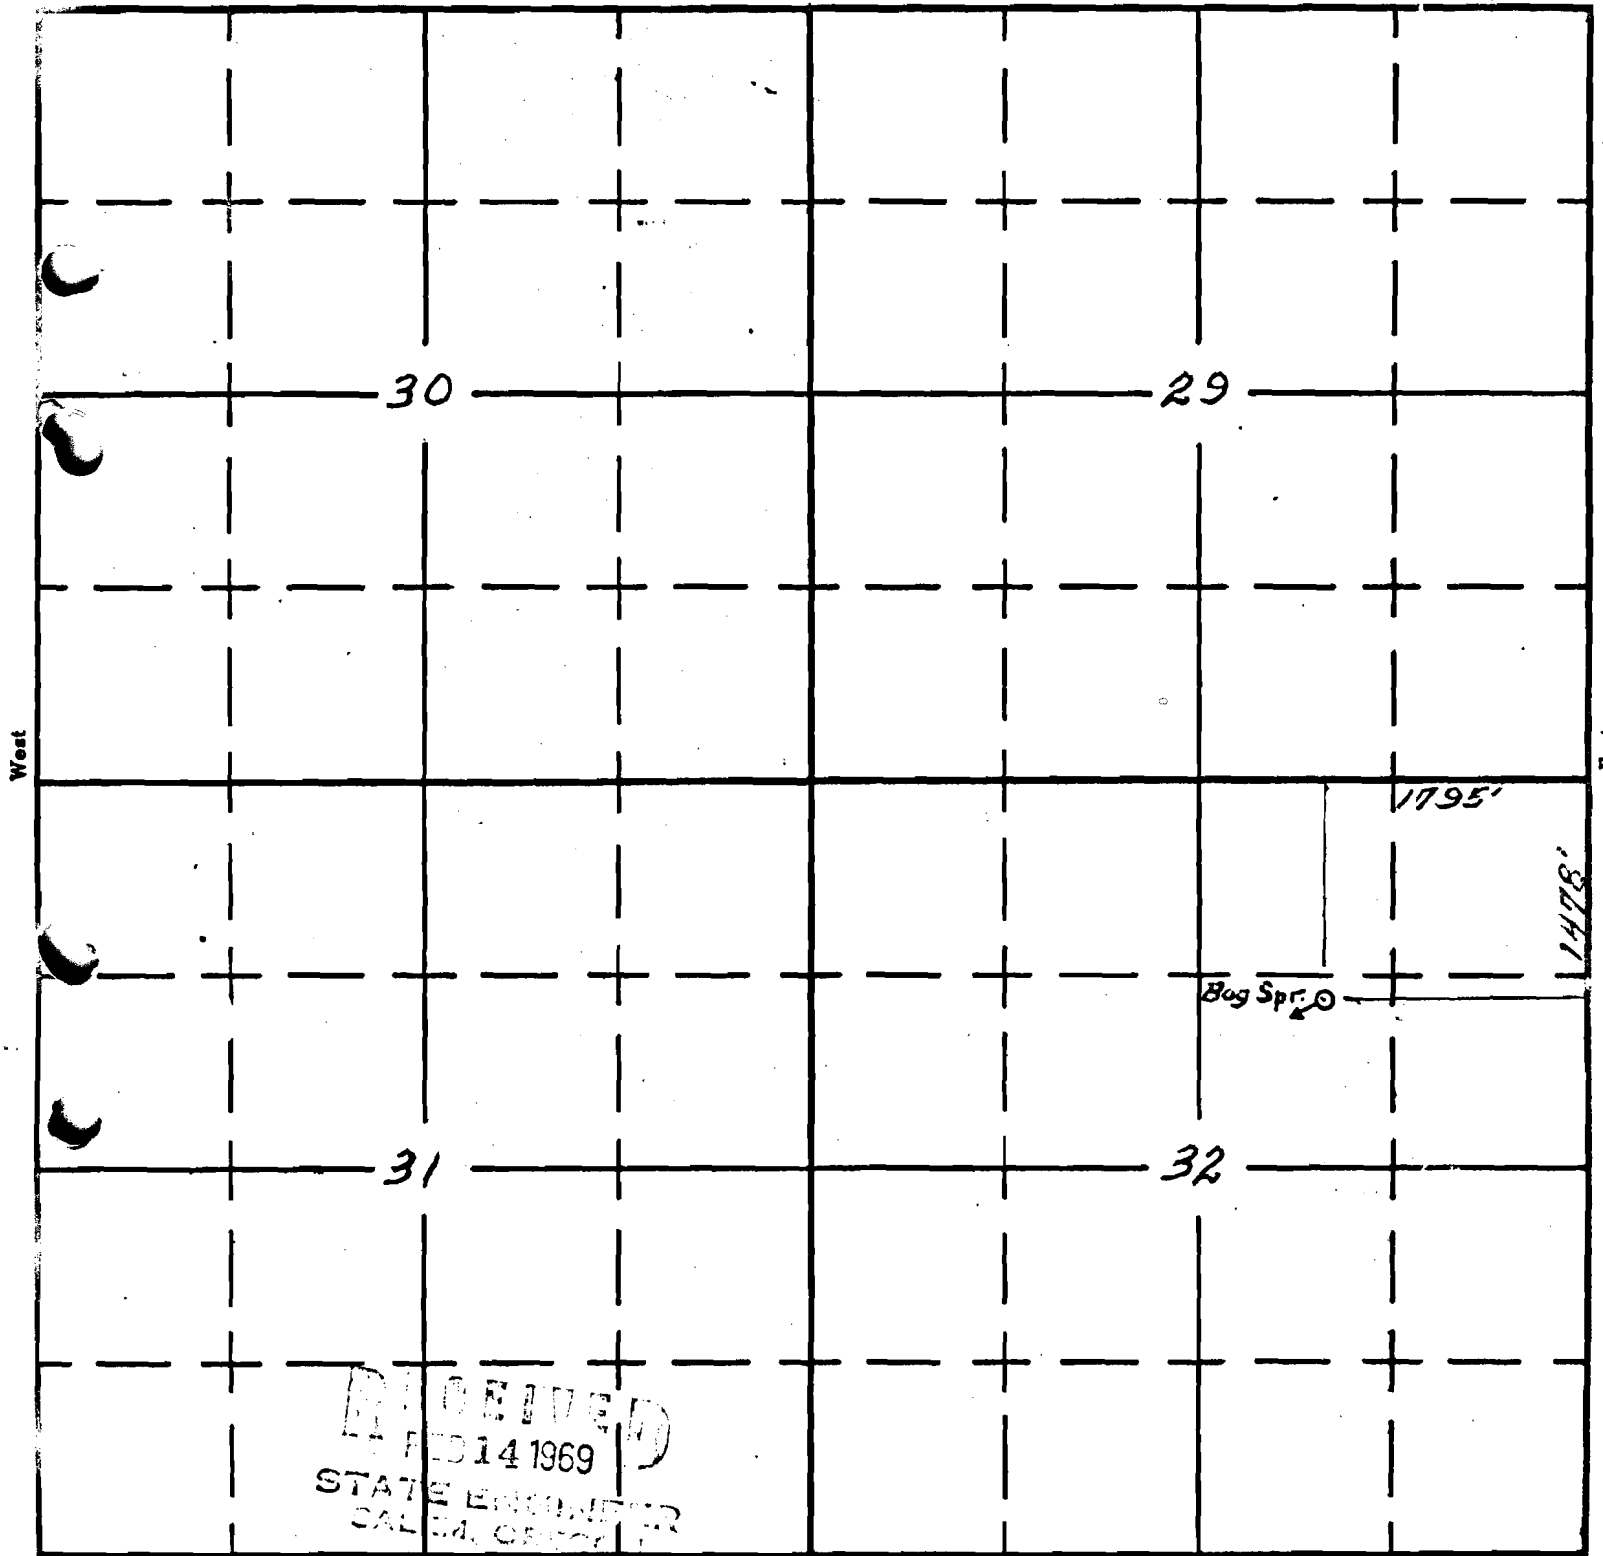

South

Rock Ck. & Misc.

APPLICATION No. 45775
PERMIT No. 34170