


T.16 S. R.2 W. W.M.

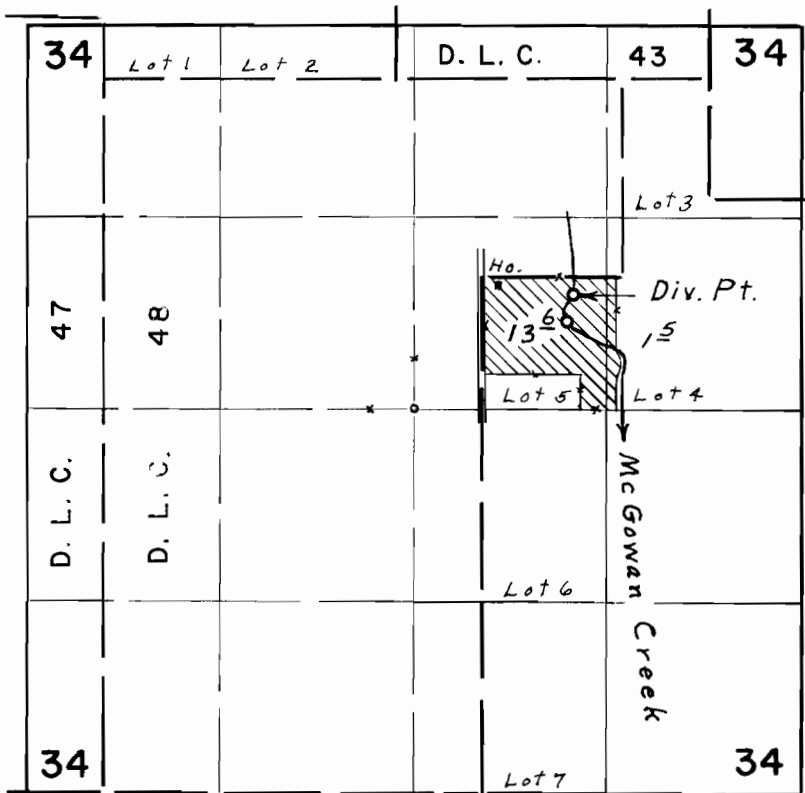

Div. Pt. located 790' N. & 1080' E. from Center Sec. 34

FINAL PROOF SURVEY

UNDER

Application No. 42675 Permit No. 31891
IN NAME OF

DAVID J. ALTMAN

Surveyed Sept. 8, 1971, by Greg Bagg.