


T.10S., R.2&3W., W.M.

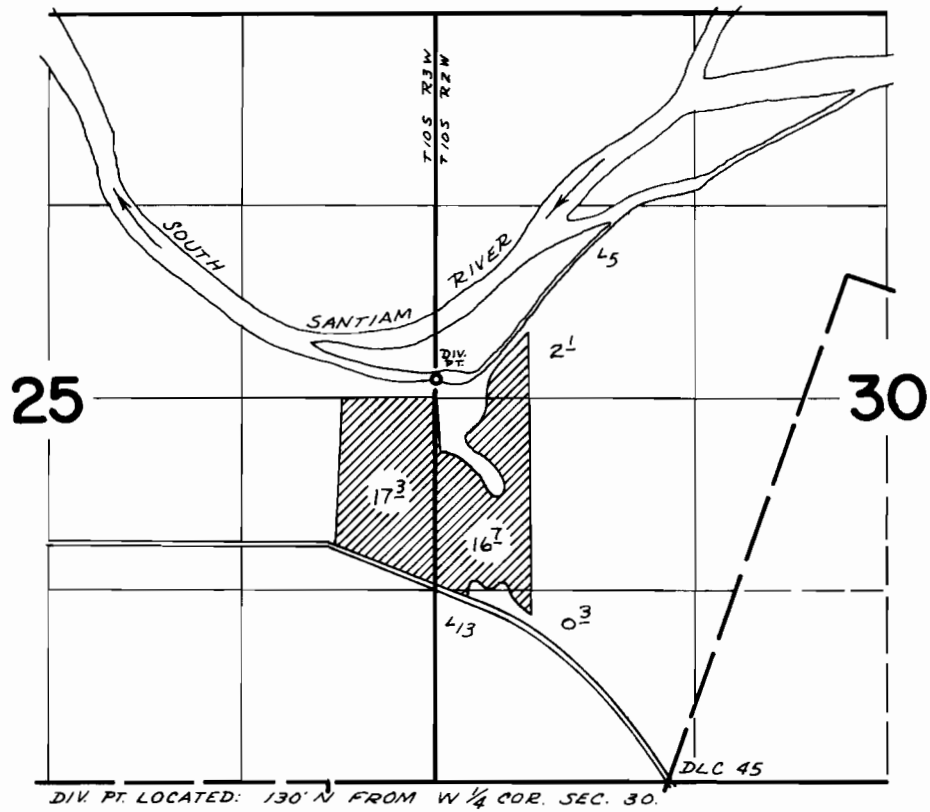

FINAL PROOF SURVEY UNDER

Application No. 42985 Permit No. 32116
IN NAME OF

RICHARD D. AND GERALDINE F. DOWNER

Surveyed Sept 1 1972, by D. Narby