


T.22S.R.46E.W.M.

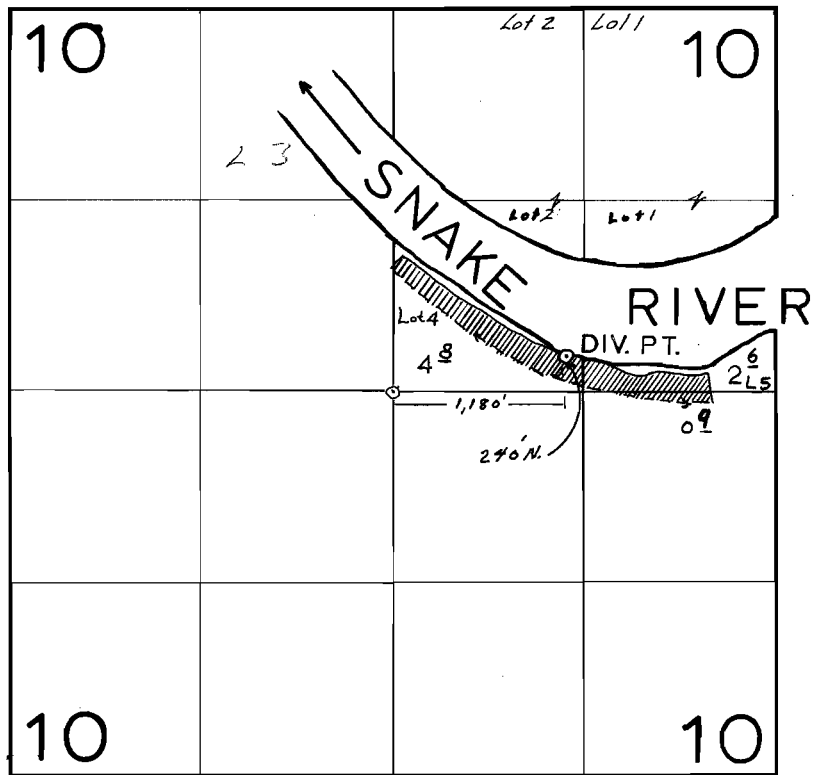

FINAL PROOF SURVEY
UNDER

Application No. 42371 Permit No. 31234
IN NAME OF

L.W. DIERKING

Surveyed Nov. 8, 1971, by E. E. FETTING