


T. 6 S. R. 2 W. W. M.

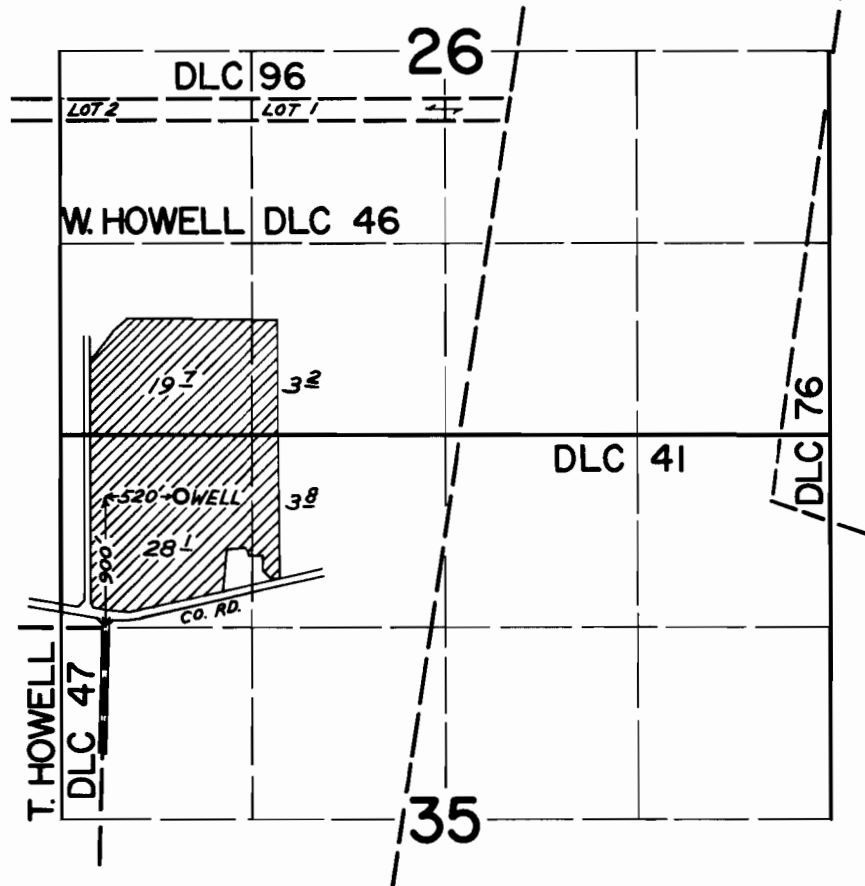

FINAL PROOF SURVEY  
UNDER

Application No. ~~G-3519~~ Permit No. ~~G-3338~~  
IN NAME OF

JOE DITCHEN

Surveyed JULY 15, 1971, by GREG BACA