


T6S. R.2W. W.M.

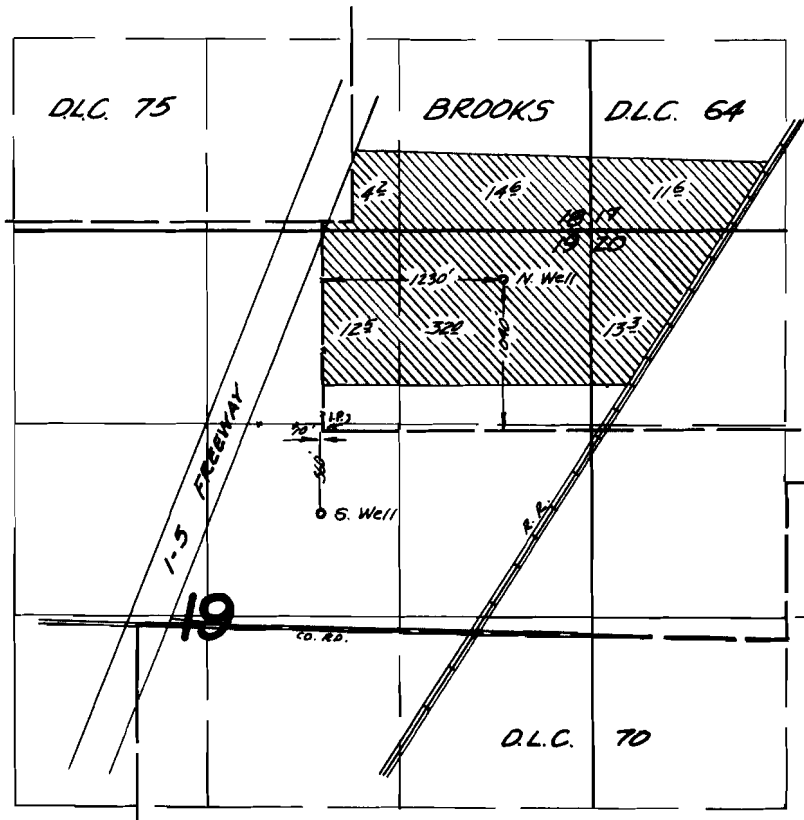

FINAL PROOF SURVEY UNDER

Application No. G-1530. Permit No. G-1052.
IN NAME OF

GEORGE N. HYBERTSEN

Surveyed Oct. 1 1972, by R.S. Macken