


T. 6 S. R. 6 W. W.M.

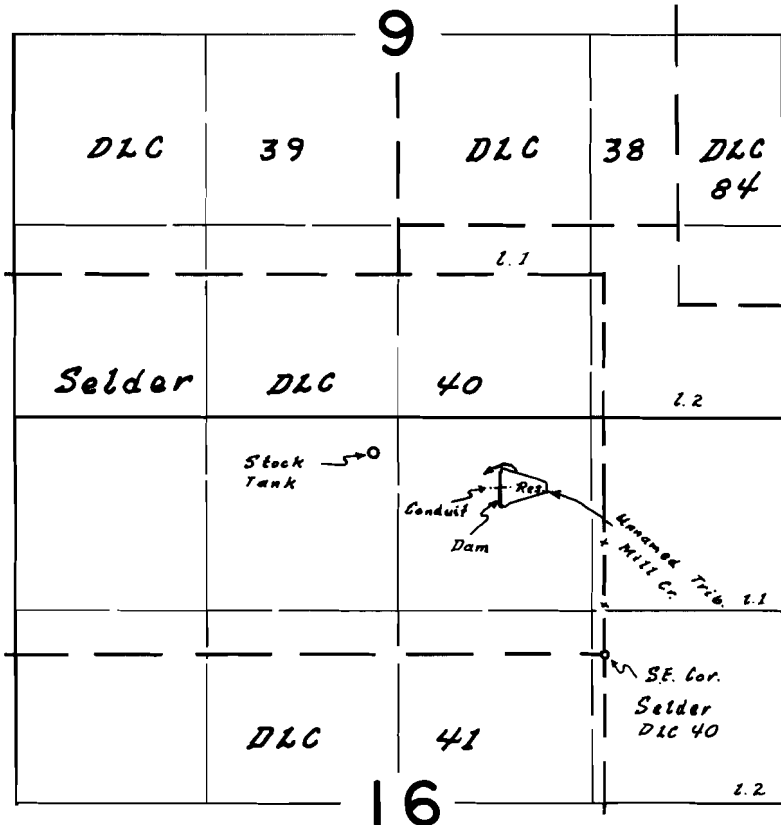

Div. Pt. Loc. 1150' N. of 720' W. from SE. Cor. Selder DLC 4

FINAL PROOF SURVEY
UNDER

Application No. R-42452 Permit No. R-4801

IN NAME OF

John Hart

Surveyed 25 May 1972 by L. E. Gould