


T. 7S. R. 5W. W.M.

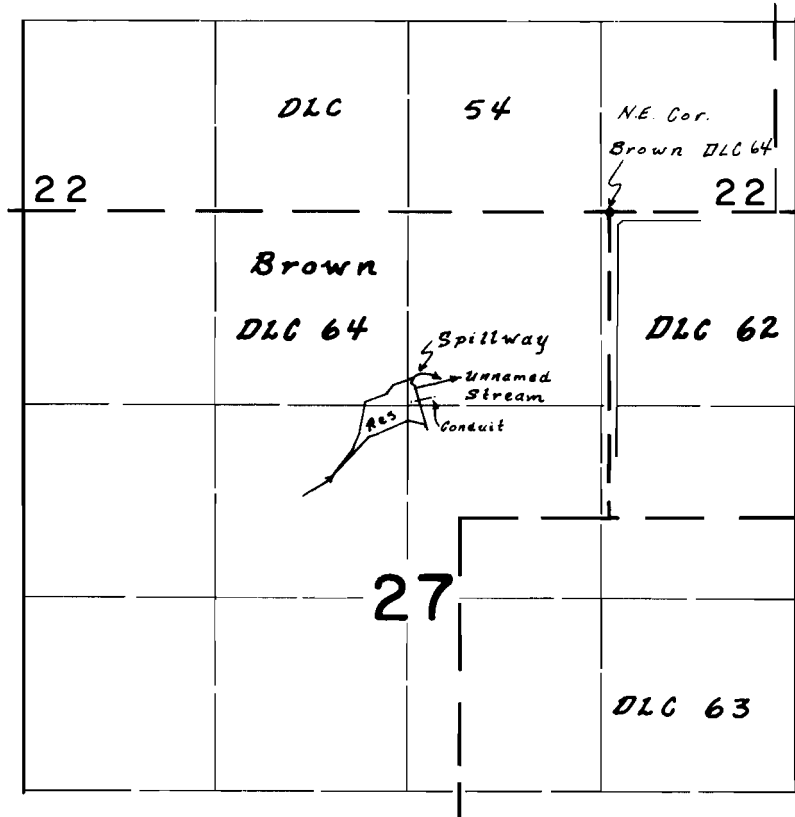

Div. Pt. loc. 1300' S. & 1300' W. from N.E. Cor. Brown DLC 64

FINAL PROOF SURVEY
UNDER

Application No. *R-47101* Permit No. *R-5578*
IN NAME OF

David Peters

Surveyed *29 Aug. 1972*, by *L.E. Gould*