


T.6 S., R.4 W., W.M.

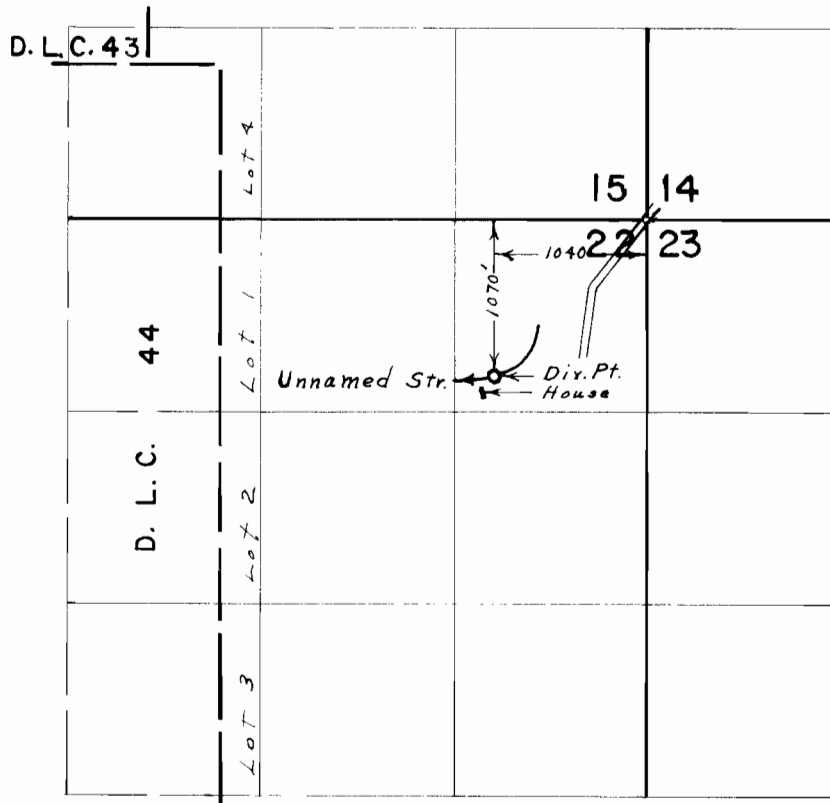

FINAL PROOF SURVEY
UNDER

Application No. 41961... Permit No. 31414...
IN NAME OF

HARRY B. HAMPTON

Surveyed April 28, 1972, by L. E. Gould...