


# T. 6 S., R. 5 W., W.M.

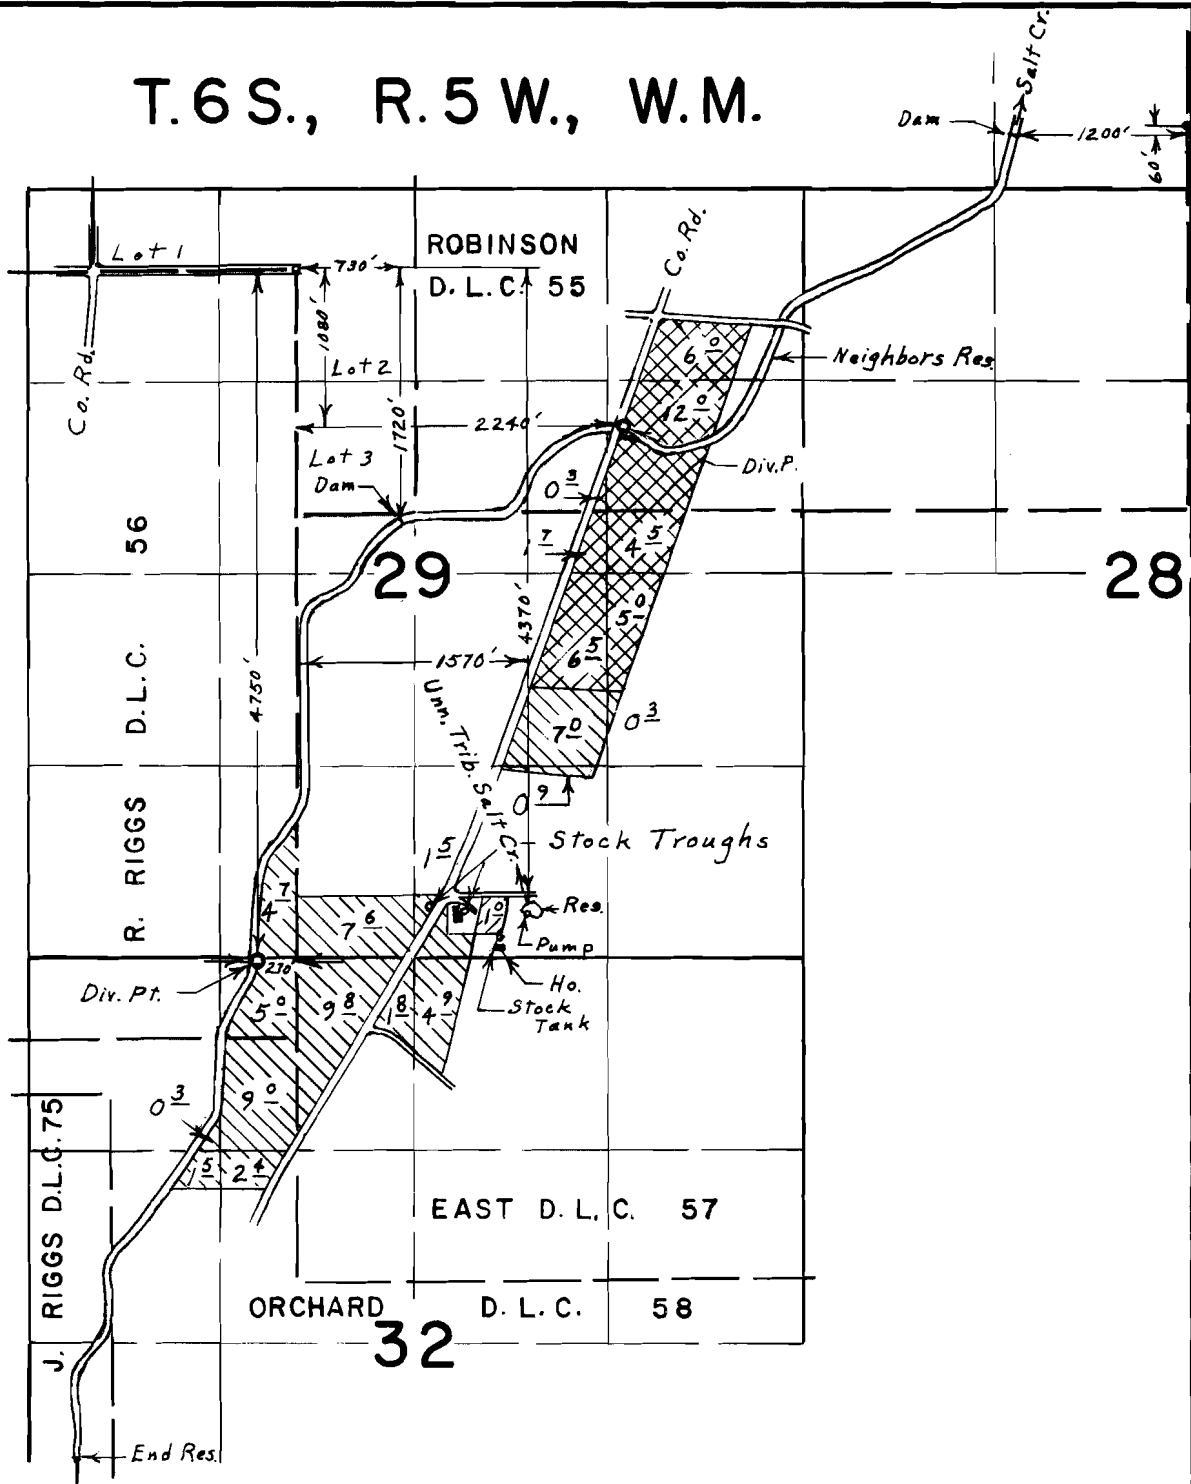

## FINAL PROOF SURVEY UNDER

47624	34972	
43136	32225	
R-43135	R-4923	

Application No. 42150 Permit No. 31729

IN NAME OF

**BERTHA MULLER**

Surveyed May 24, 1972, by L. E. Gould