


T. 6 S., R. 5 W., W.M.

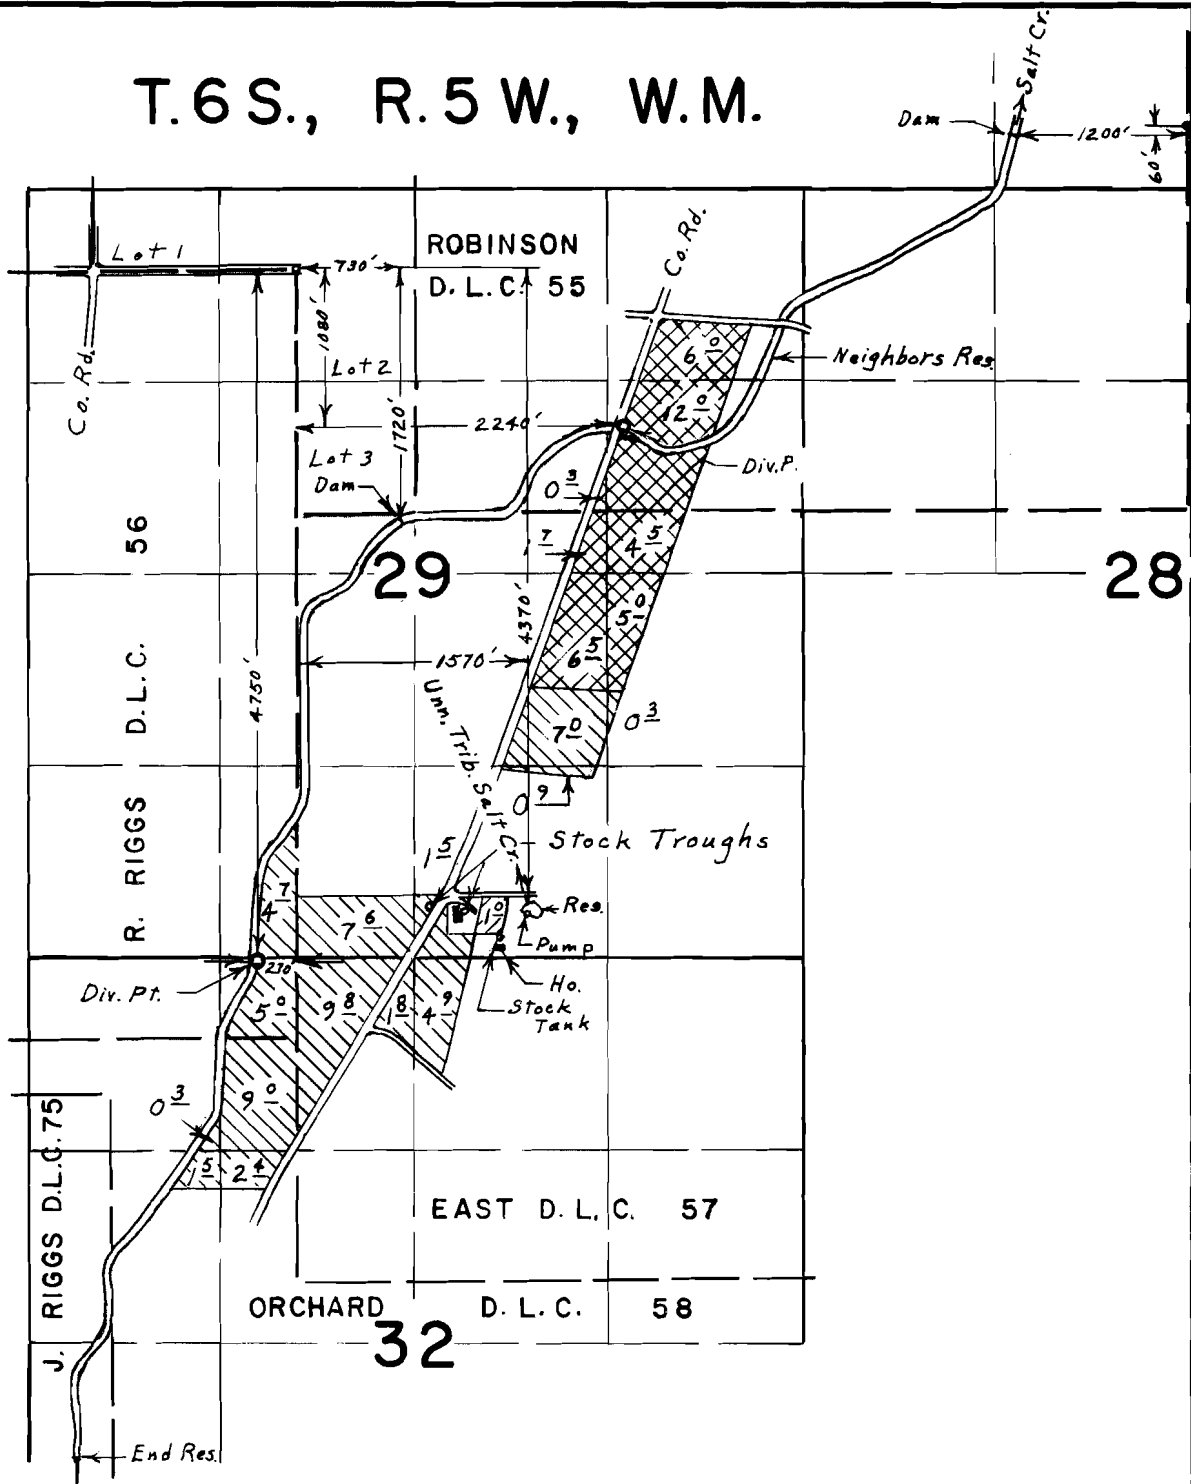

FINAL PROOF SURVEY

UNDER

47624

43136

R-43135

Application No. 42150

IN NAME OF

BERTHA MULLER

Surveyed May 24, 1972, by L. E. Gould

34972

32225

R-4923

Permit No. 31729

