


T. 6 S. R. 8 W. W. M.

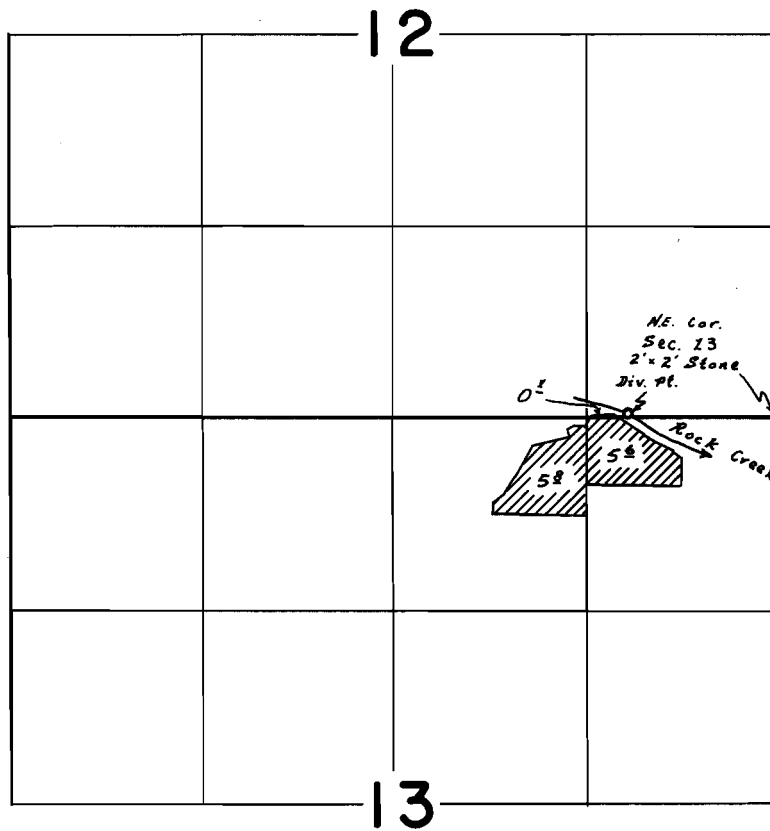

Div. Pt. loc. 30' N. & 104' W. from NE. Cor. Sec. 13

FINAL PROOF SURVEY
UNDER

Application No. 43906 Permit No. 32815
IN NAME OF
Arthur N. Soules

Surveyed 29 Sept 1972, by L.F. Gould